


Property Key

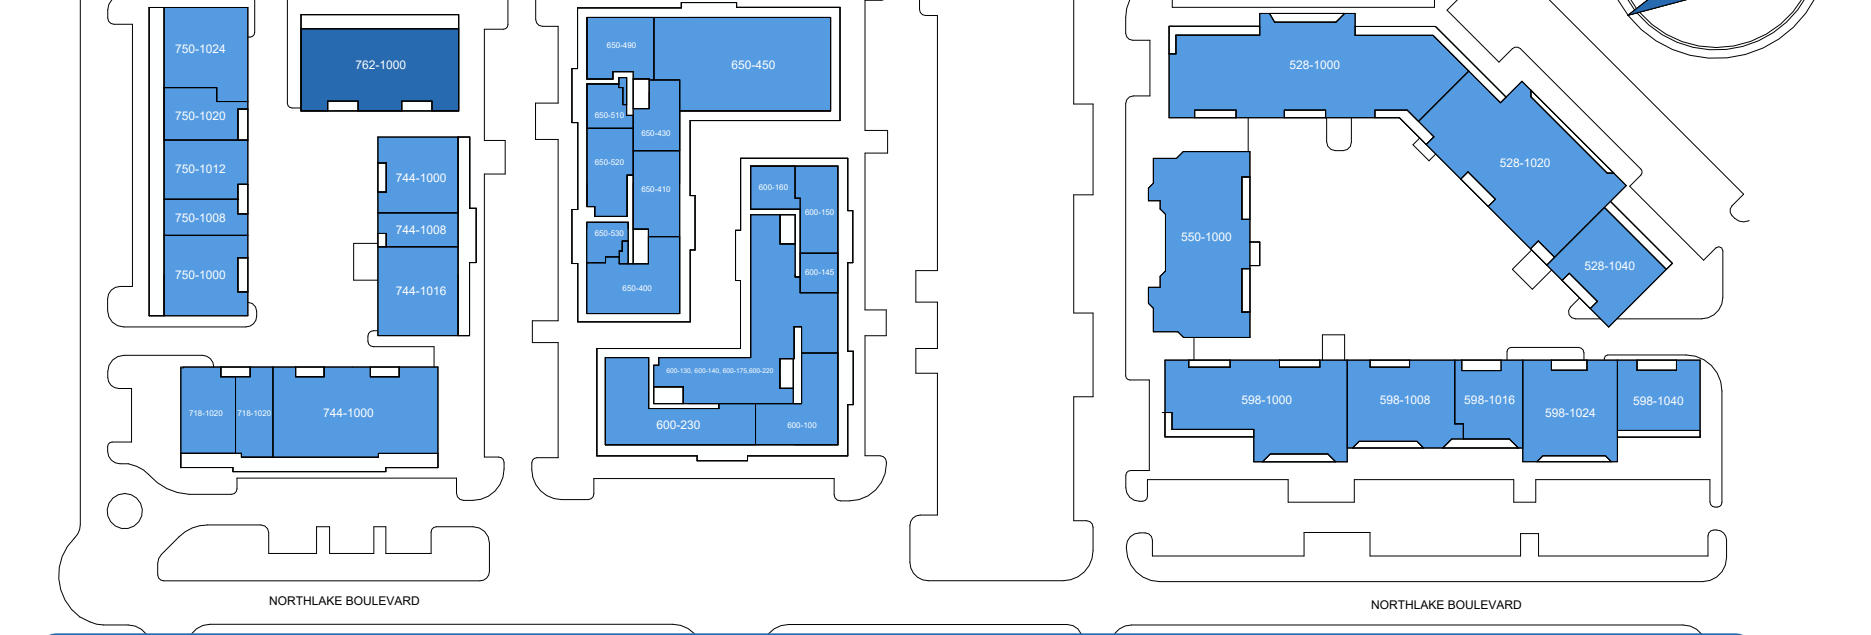


Alt Springs As Built Marketing Package

762 Northlake Blvd, Alt Springs, FL 32701, US

Building: 762
Suite: 1000
Sheet **E1**

Scale: Not to Scale
Sheet Size: 42" x 30"
Not For Construction

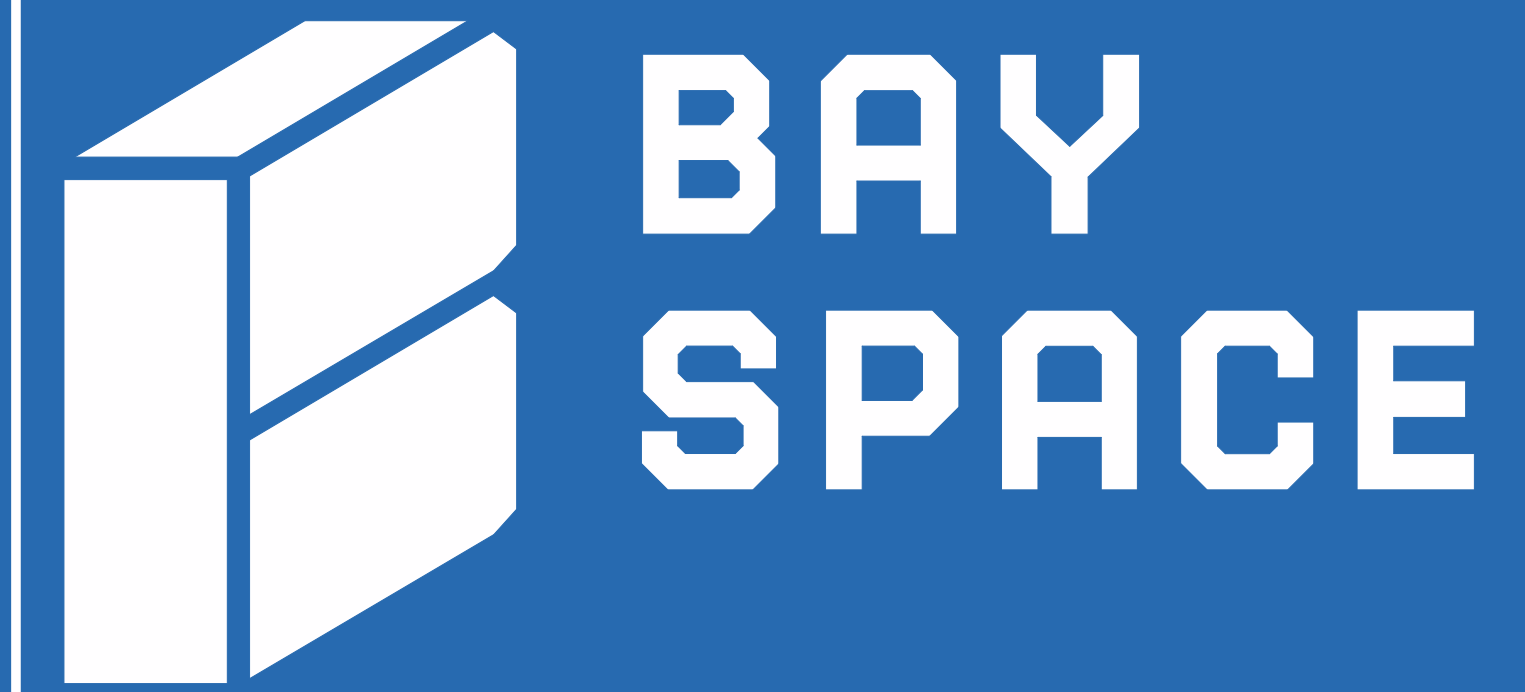

Usable Square Foot Analysis

Office Area	8,055	100 %
Warehouse Area	0	0%
Total Area	8,055	

Building Information

Deck Height:	N/A	
Clear Height:	8' - 10 1/2"	
Ceiling Height:	8' - 10 1/2"	
Sprinklered:	<input checked="" type="checkbox"/> Yes	<input type="checkbox"/> No
Mechanical Area:	64 SQFT	

