


# 900 Jorie Blvd

900 Jorie Blvd.  
Oak Brook, IL 60523

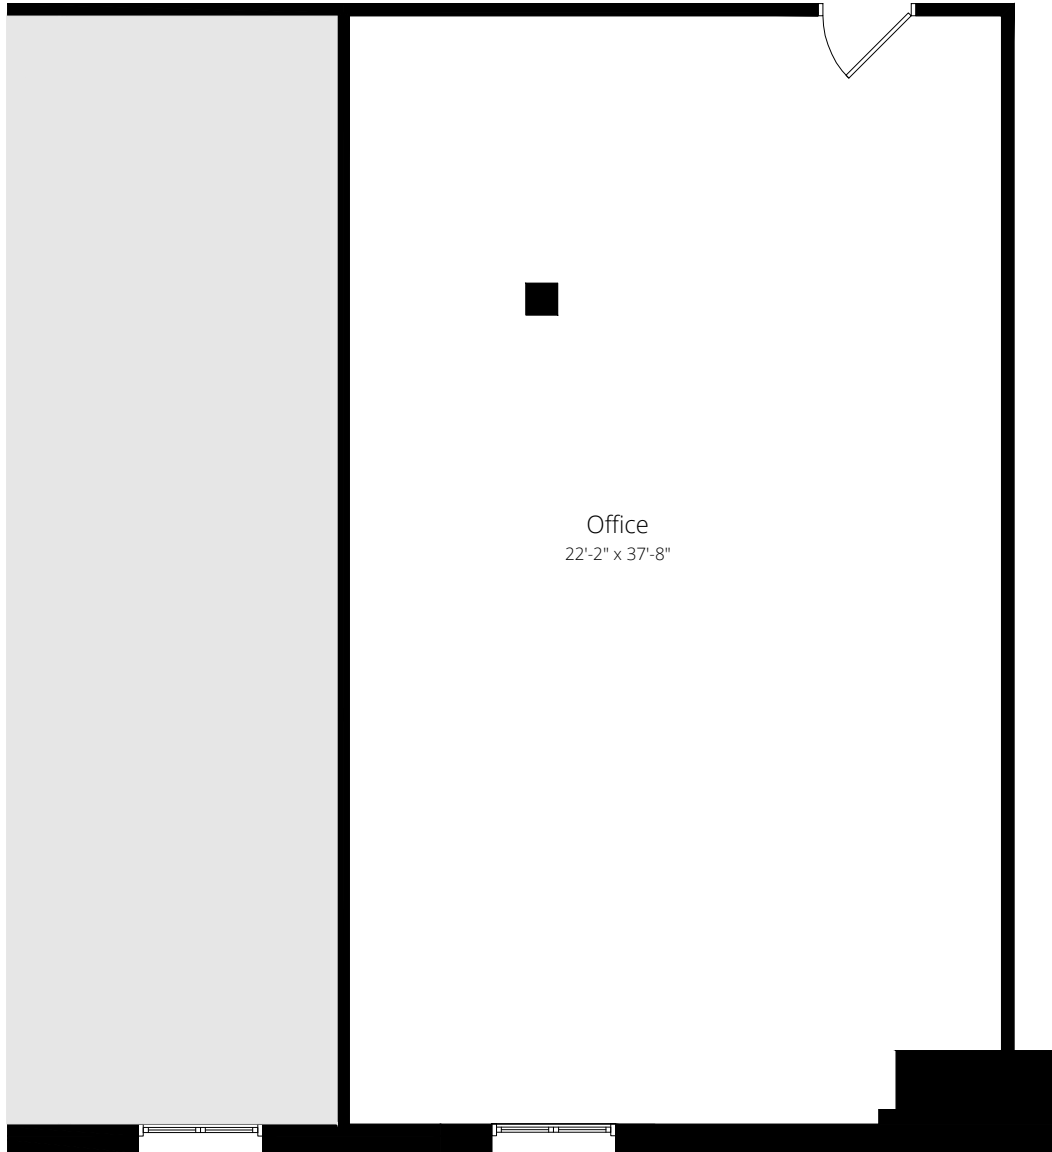

## Suite 212 - As-Built MP-1

967 Rentable Square Feet

Scale:

N.T.S.

