


SPACE AVAILABLE

SUITE 500: 1,545 SF

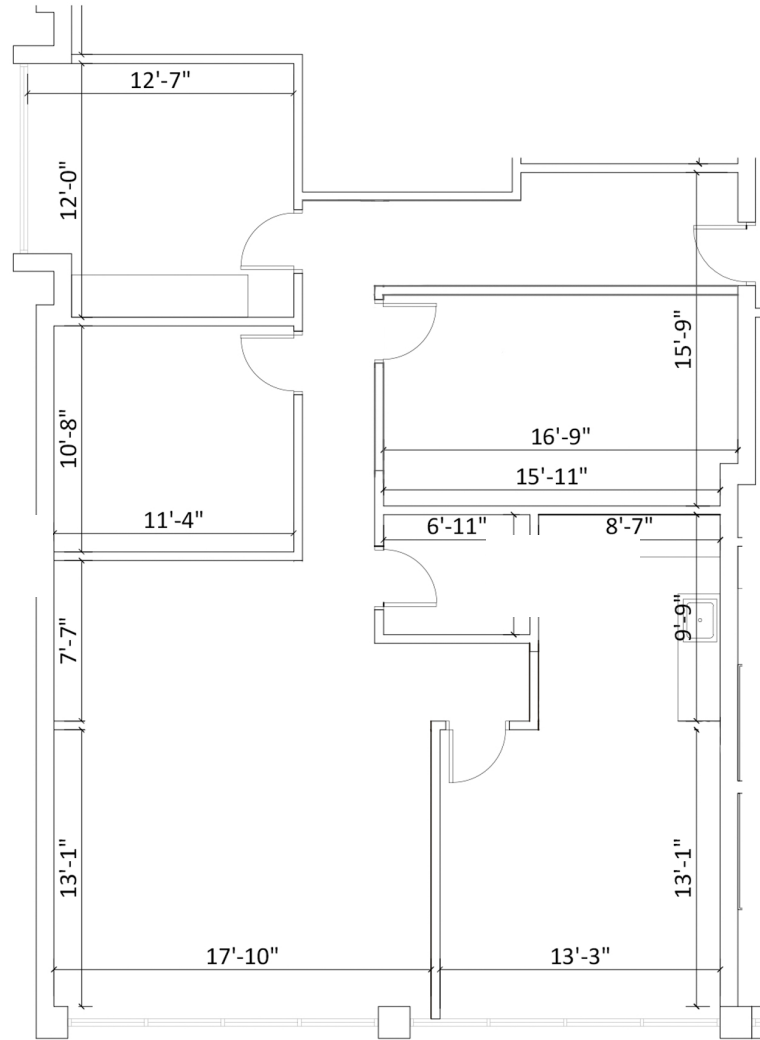

WESTSHORE CITY CENTER
1211 N. Westshore Blvd
Tampa, FL 33607

No warranty or representation, expressed or implied, is made to the accuracy of information contained herein, and same is submitted subject to errors, change of price, rental or other conditions, withdrawal without notice, and to any special listing conditions imposed by our principals. PLANS NOT TO SCALE

MATT ALEXANDER | DIRECTOR
Matthew.Alexander@FranklinSt.com | 813.559.2006

LORENZO GONZALEZ | SENIOR ASSOCIATE
813.793.8421 | Lorenzo.Gonzalez@FranklinSt.com

 **FranklinStreet**
Licensed Real Estate Broker | FranklinSt.com