


LAKE SHORE

18111 VON KARMAN AVENUE
8th floor



SCALE: N.T.S.

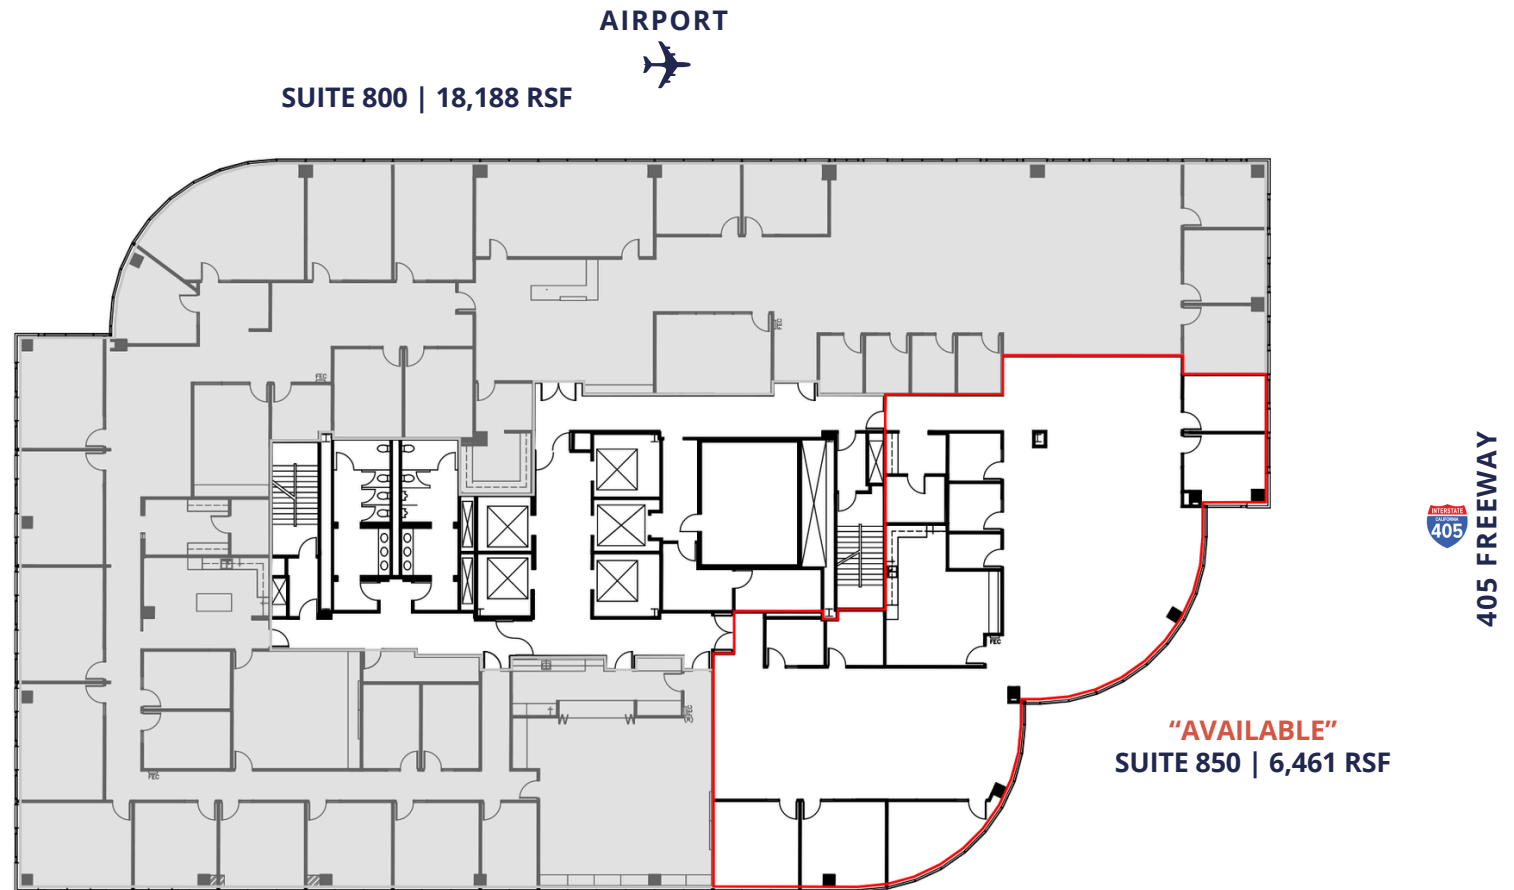

SENTRE

REVISED: 1/17/26