


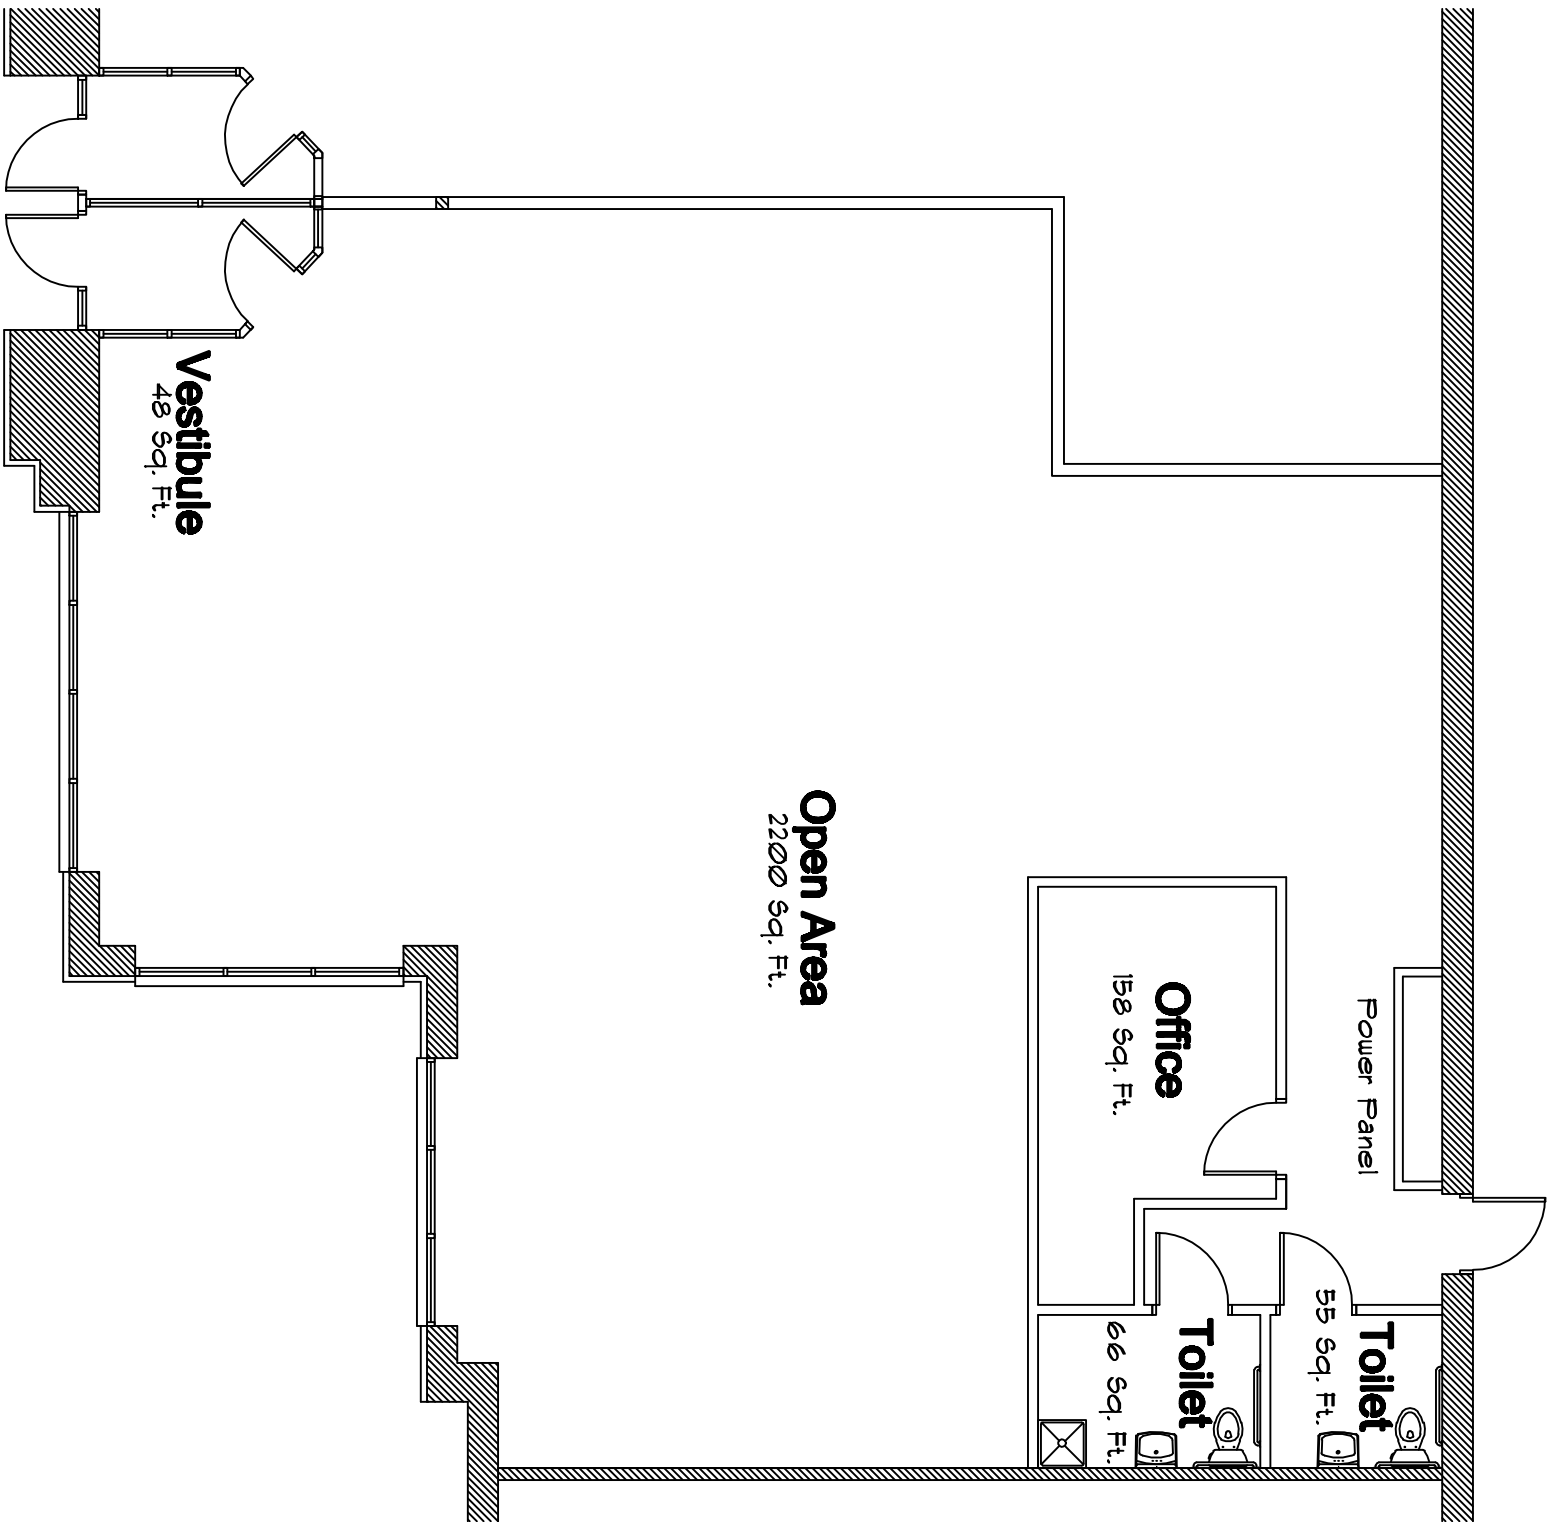

TENANT SPACE

1/8"=1'-0"

2,500 Usable Square Feet
November 12, 2012