




101	104	105	106	107	108	109	110	111	112	113	114
-----	-----	-----	-----	-----	-----	-----	-----	-----	-----	-----	-----

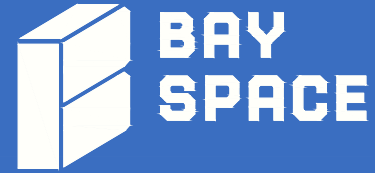


Usable Square Foot Analysis

OFFICE AREA:	550	19%
WAREHOUSE AREA:	2,307	81%
OVERHANG AREA:	41	
TOTAL AREA:	2,898	

Building Information

Deck Height:	14'5"
Clear Height:	10'11"
Ceiling Height:	8'
Sprinklered:	No
Mechanical Area:	N/A

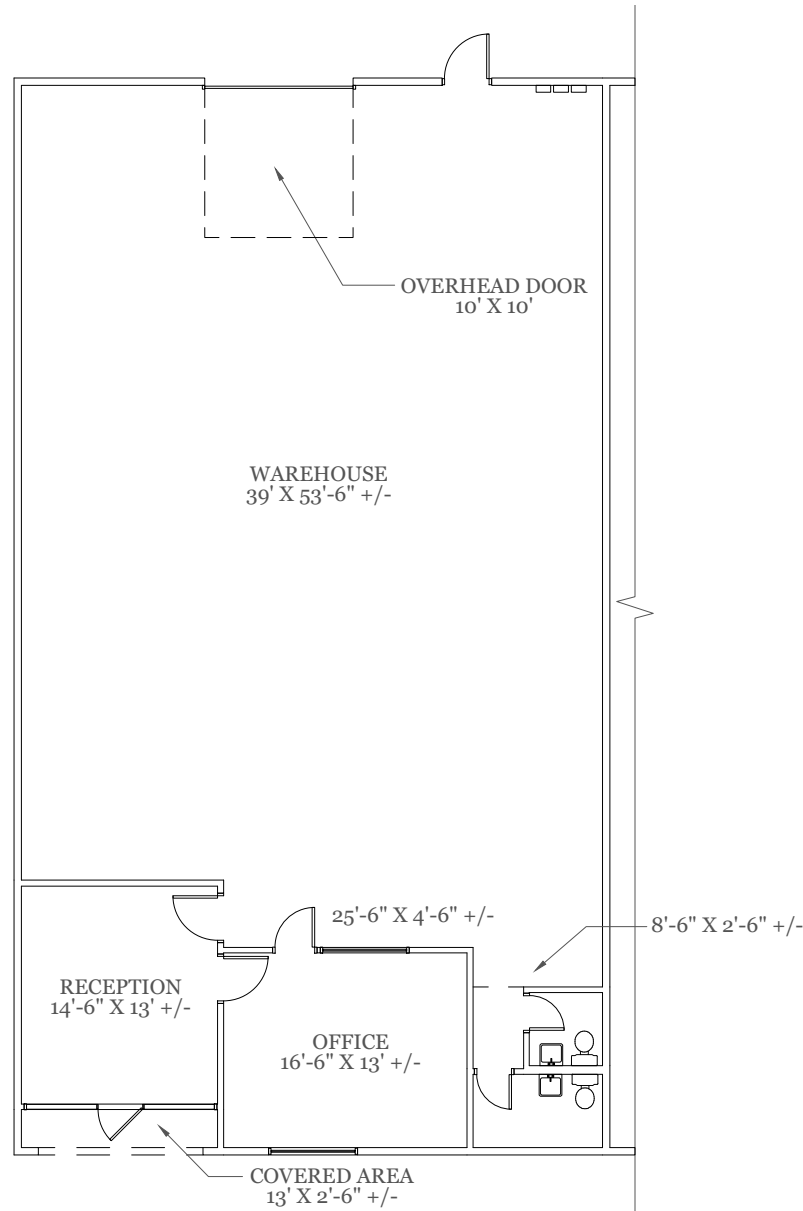

As Built Floor Plan for Marketing

