

Property Key



3904 Corporex Drive As Built Marketing Package


3904 Corporex Drive, Tampa, FL 33619



BAY SPACE

Building: 2
Suite: 150
Sheet: A-9

Scale: Not to Scale
Sheet Size: 8.5" x 11"
Not For Construction

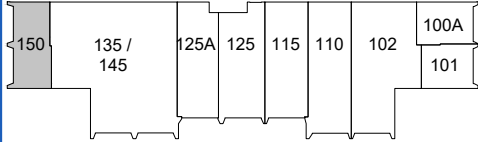

Total Area - 1,581 SF

Building Information

DECK HEIGHT:	N/A
CEILING HEIGHT:	8'-4"
CLEAR HEIGHT:	8'-4"
SPRINKLERED:	No

