

## CENTRAL PHYSICIANS PLAZA


### Floor 03

Suite 311

AS-BUILT

1,362 SF

AVAILABLE

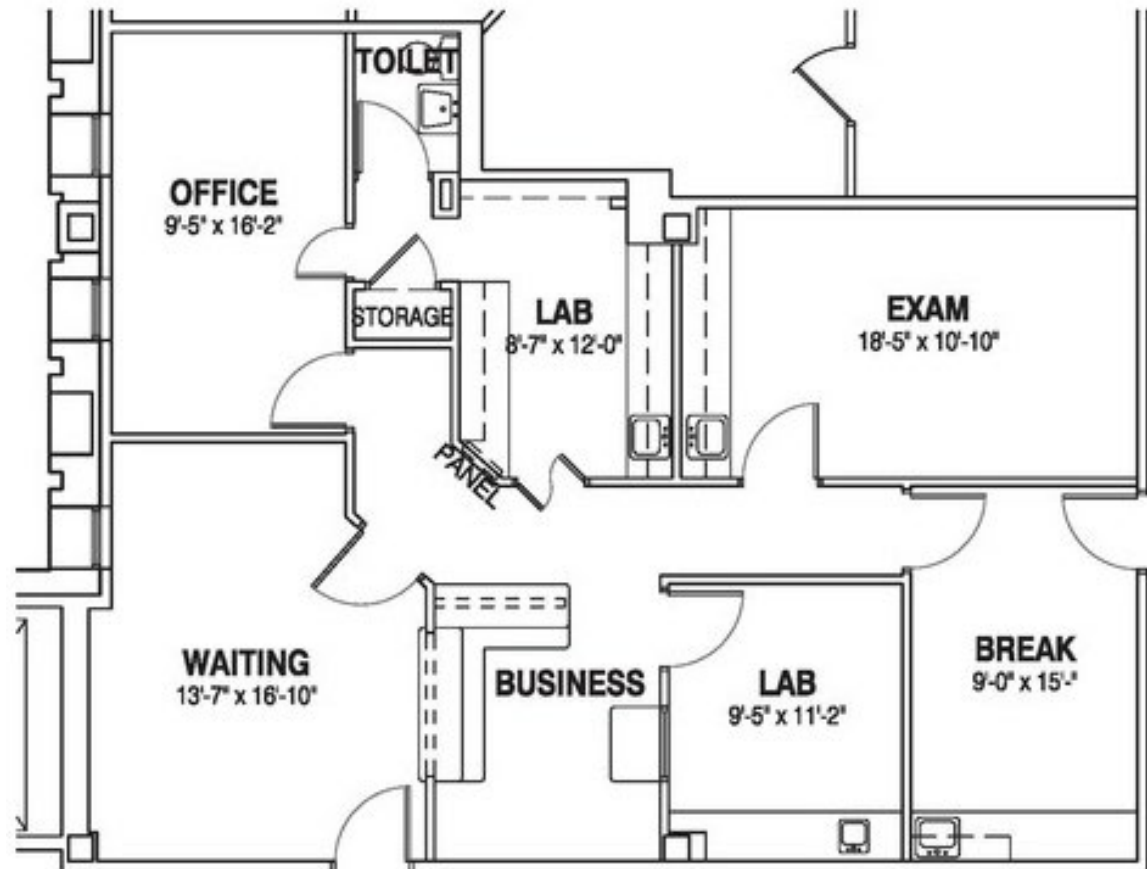

**RACHAEL THOMPSON**  
Senior Vice President  
602.513.5122  
rachael.thompson@kidder.com

**PERRY GABUZZI, CCIM**  
Senior Vice President  
602.513.5116  
perry.gabuzzi@kidder.com



View Portfolio