


"AVAILABLE"
SUITE 1400 | 23,194 RSF

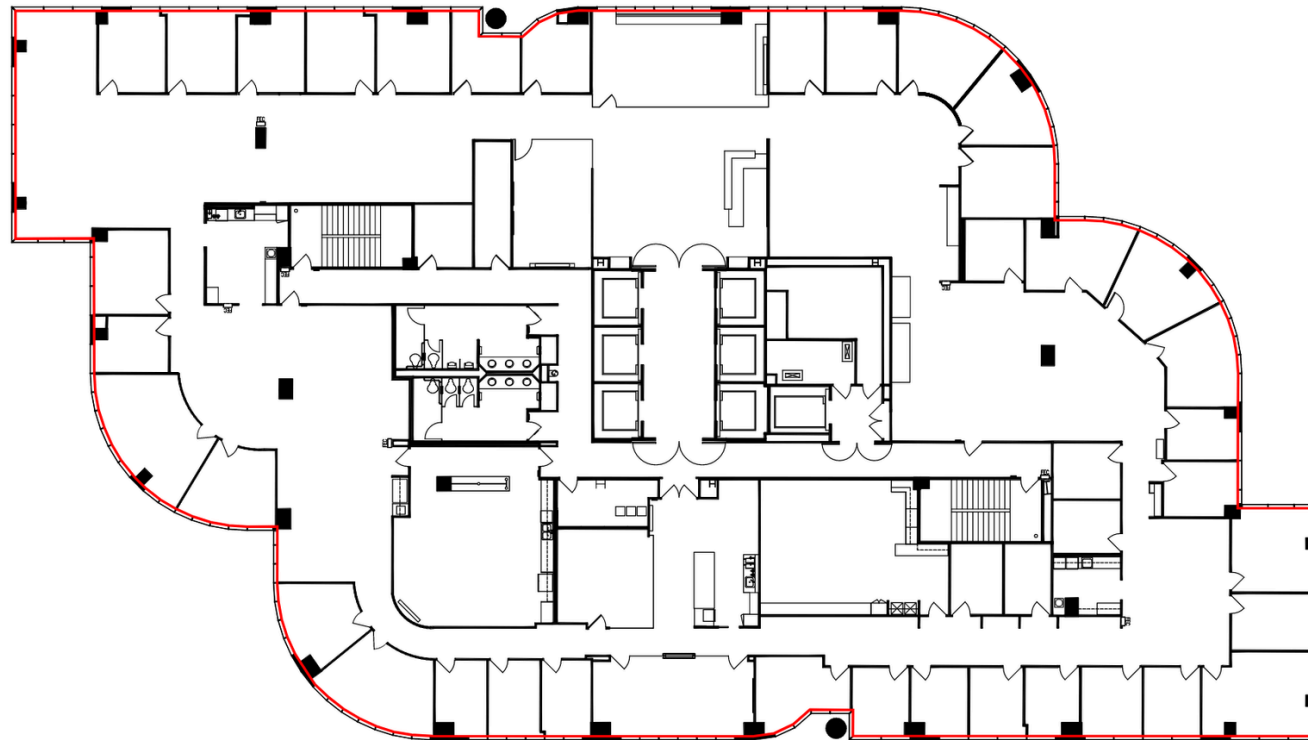

405 FREEWAY



AIRPORT



SCALE: N.T.S.



SENTRE