





AS-BUILT - 05.13.15

A4

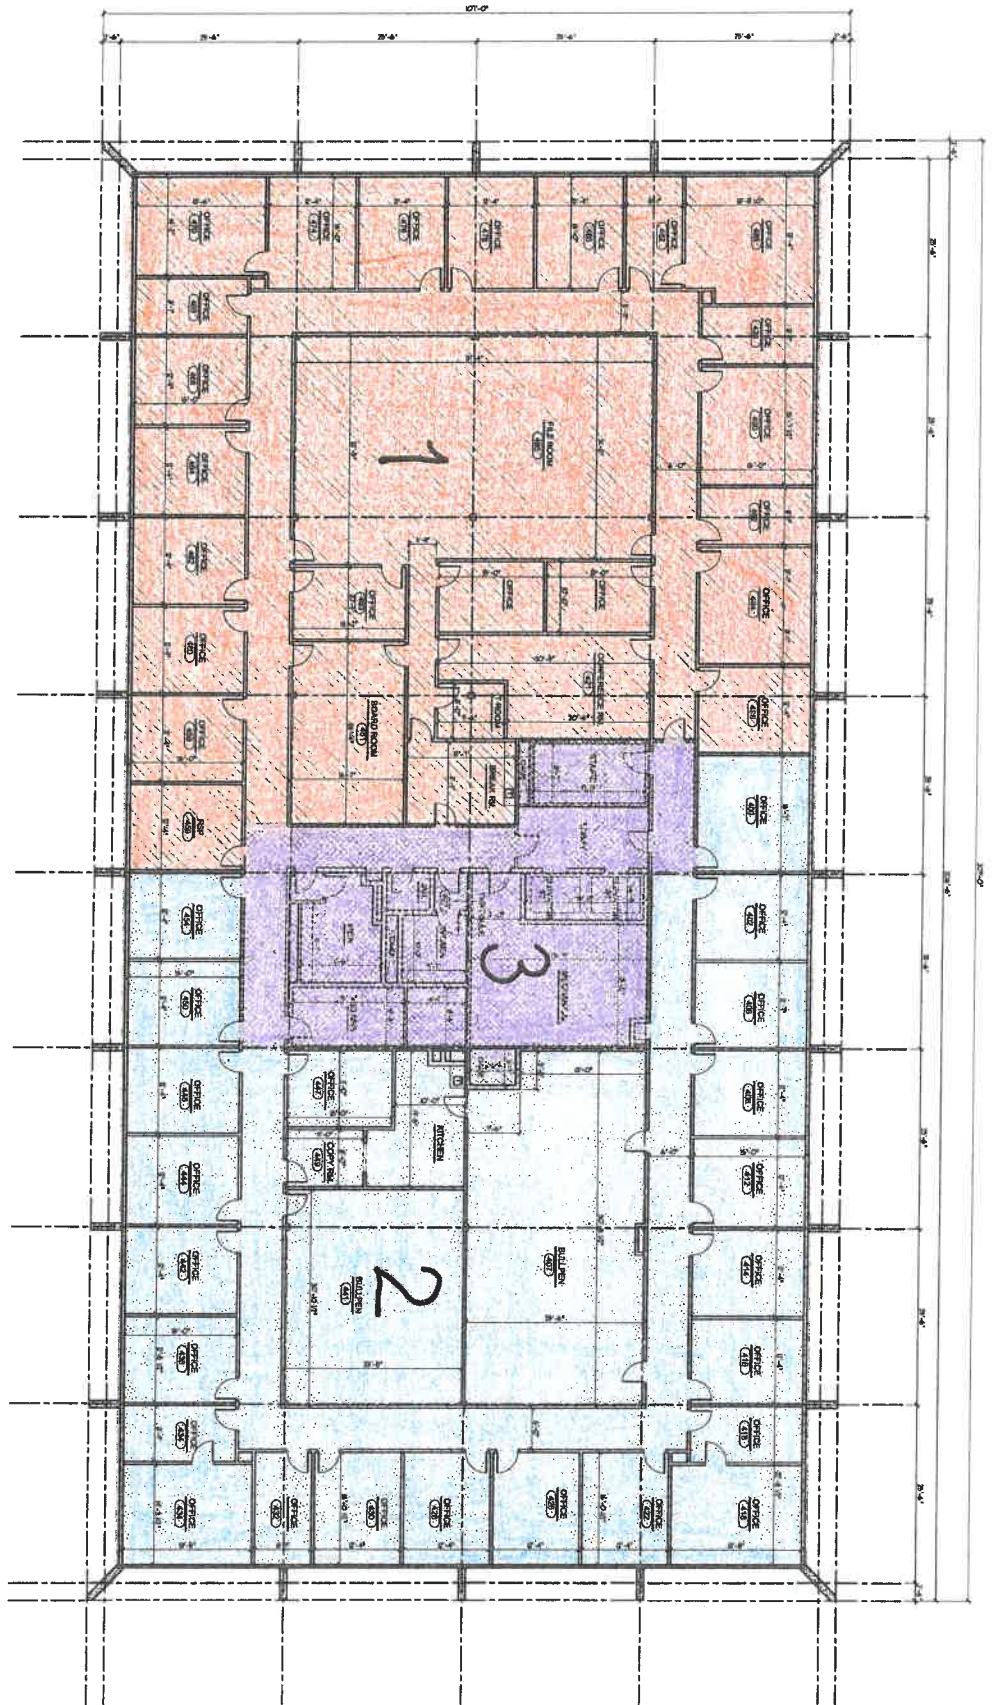

VICTOR J. PATINO, NCARB

200 N. TEXAS AVE. & LUTY
CHEROKEE, TEXAS
972-244-8888
www.vjpatino.com

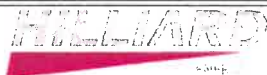

Marathon Building
125 West Missouri, Midland TX