


OAK VALLEY SUBDIVISION

SCALE 1"=300' (24"X36")
1"=600'+/- (11"X17")

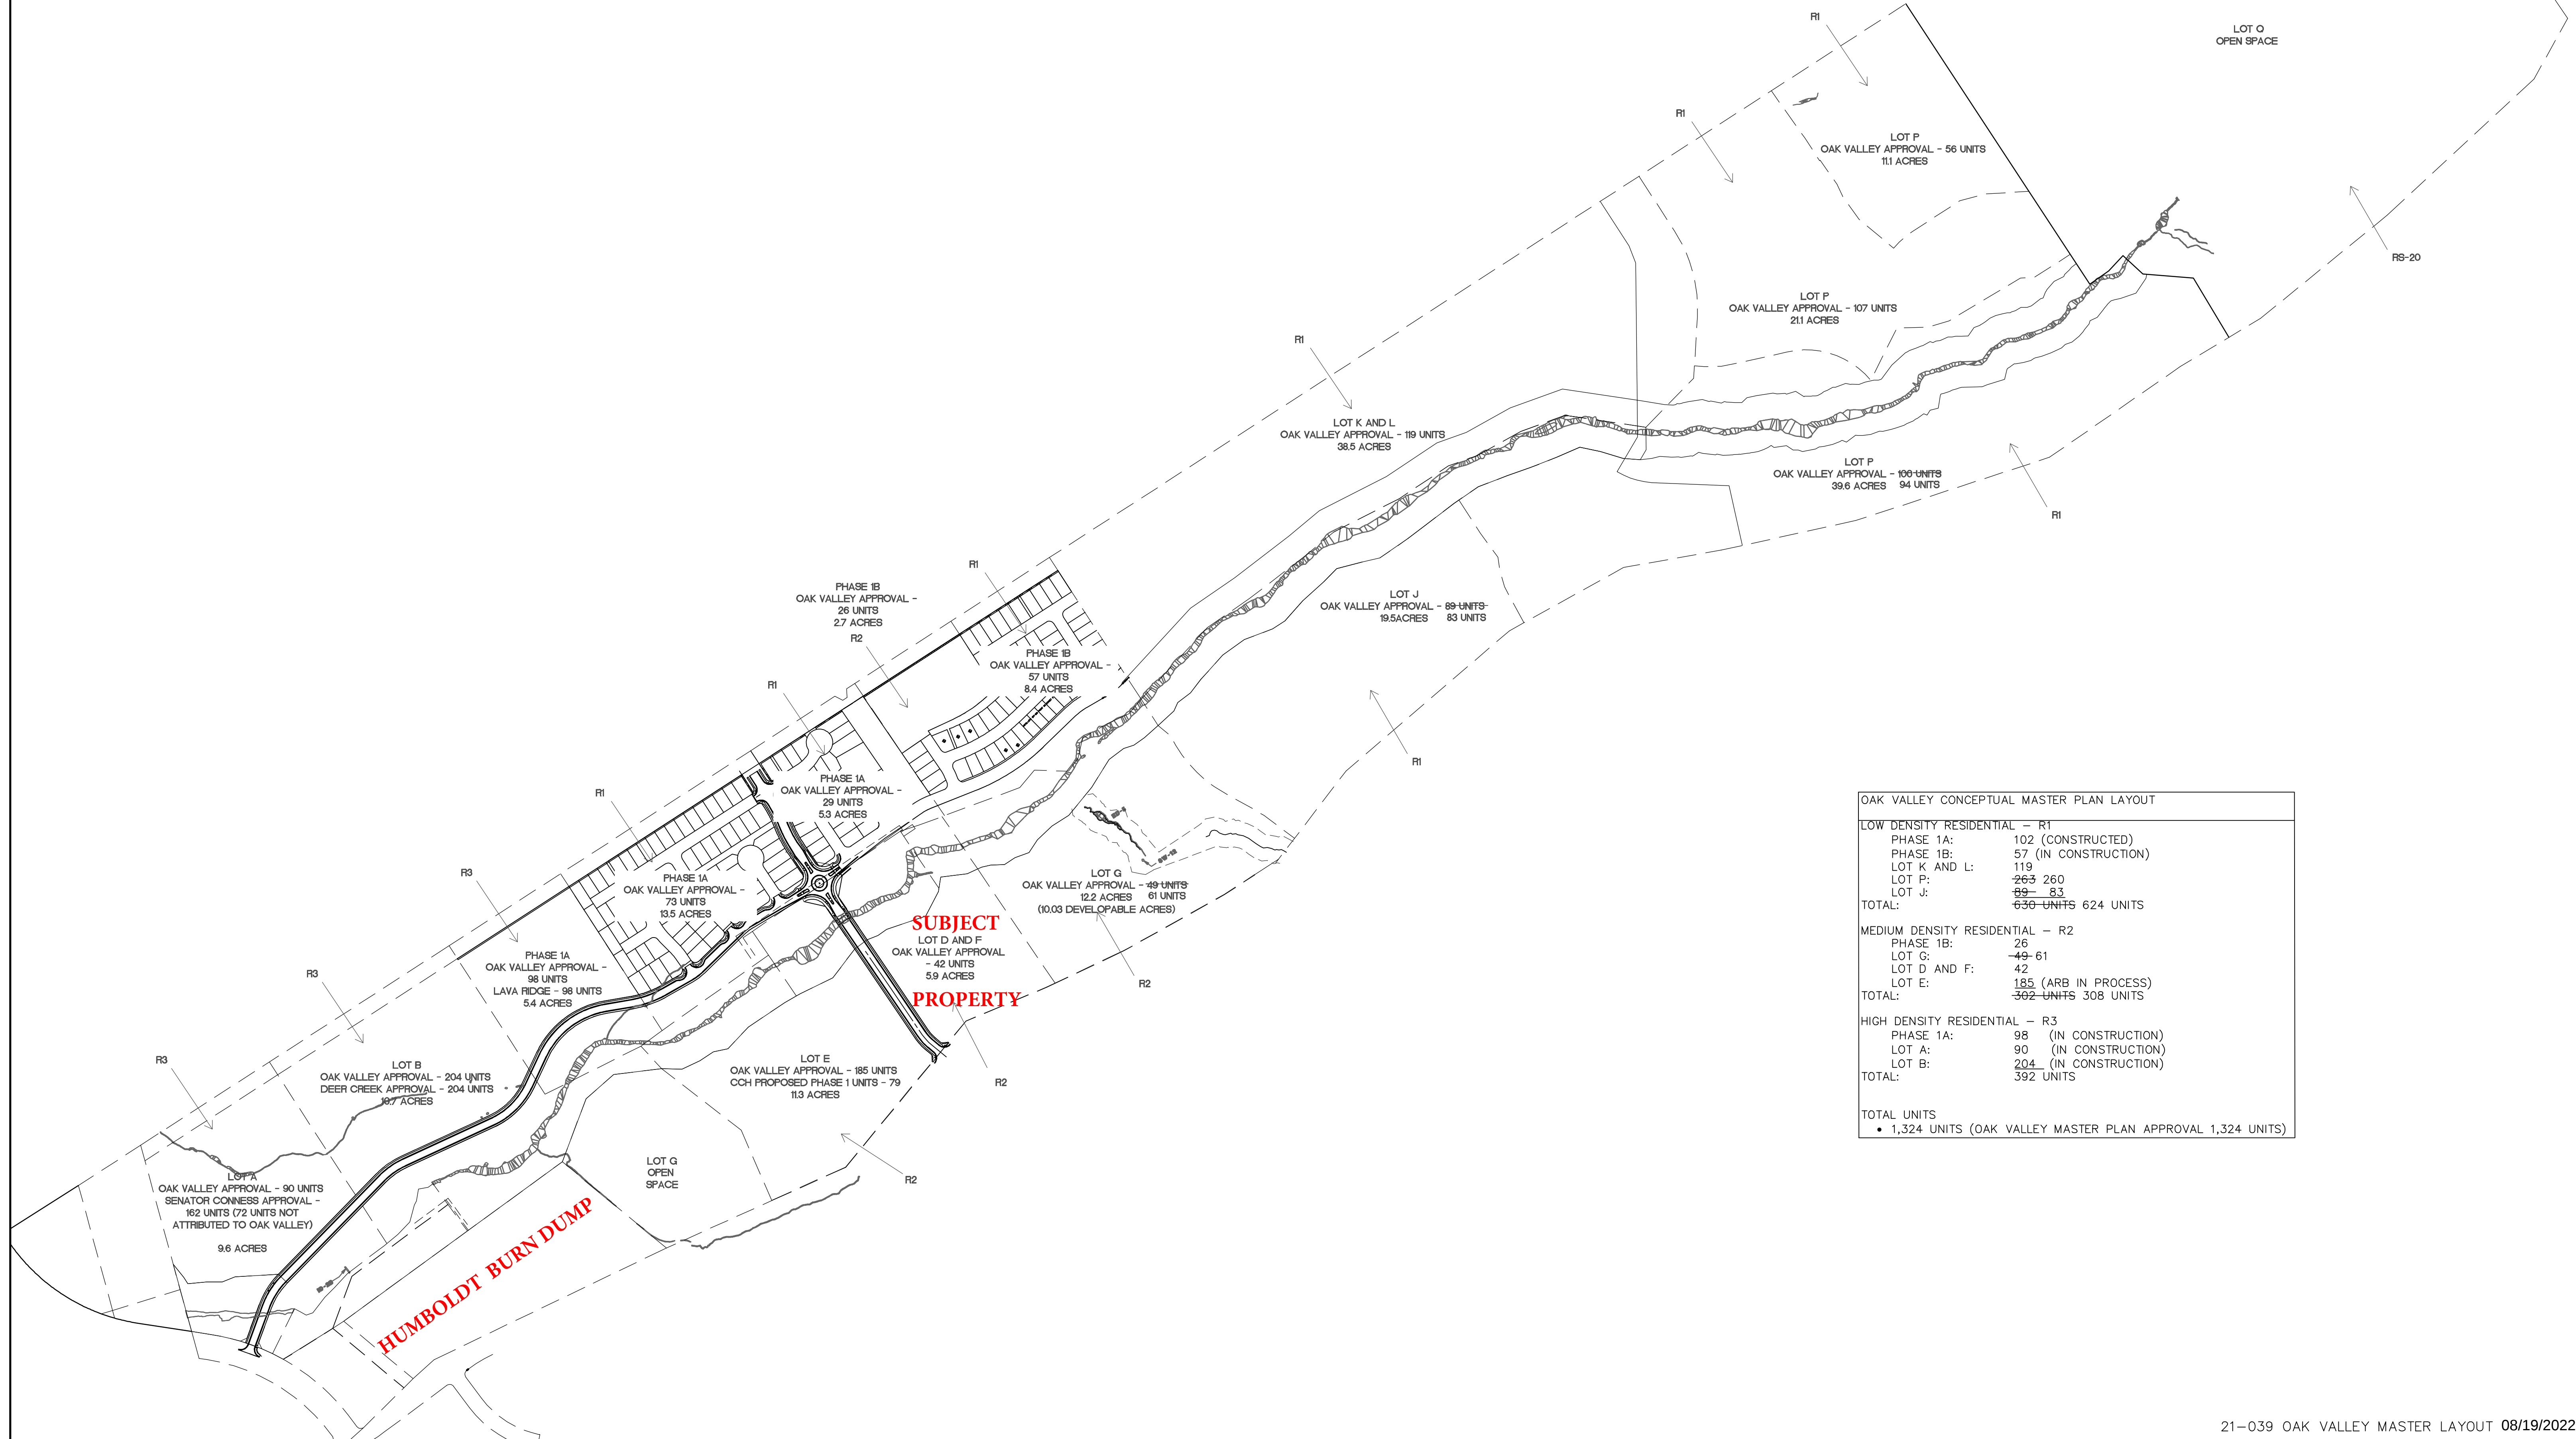

OAK VALLEY CONCEPTUAL MASTER PLAN LAYOUT	
LOW DENSITY RESIDENTIAL - R1	
PHASE 1A:	102 (CONSTRUCTED)
PHASE 1B:	57 (IN CONSTRUCTION)
LOT K AND L:	119
LOT P:	263 260
LOT J:	89 83
TOTAL:	638 UNITS 624 UNITS
MEDIUM DENSITY RESIDENTIAL - R2	
PHASE 1B:	26
LOT G:	49 61
LOT D AND F:	42
LOT E:	185 (ARB IN PROCESS)
TOTAL:	302 UNITS 308 UNITS
HIGH DENSITY RESIDENTIAL - R3	
PHASE 1A:	98 (IN CONSTRUCTION)
LOT A:	90 (IN CONSTRUCTION)
LOT B:	204 (IN CONSTRUCTION)
TOTAL:	392 UNITS
TOTAL UNITS	
• 1,324 UNITS (OAK VALLEY MASTER PLAN APPROVAL 1,324 UNITS)	