



MCDOWELL PROFESSIONAL PLAZA
1301 E MCDOWELL RD, PHOENIX AZ 85006

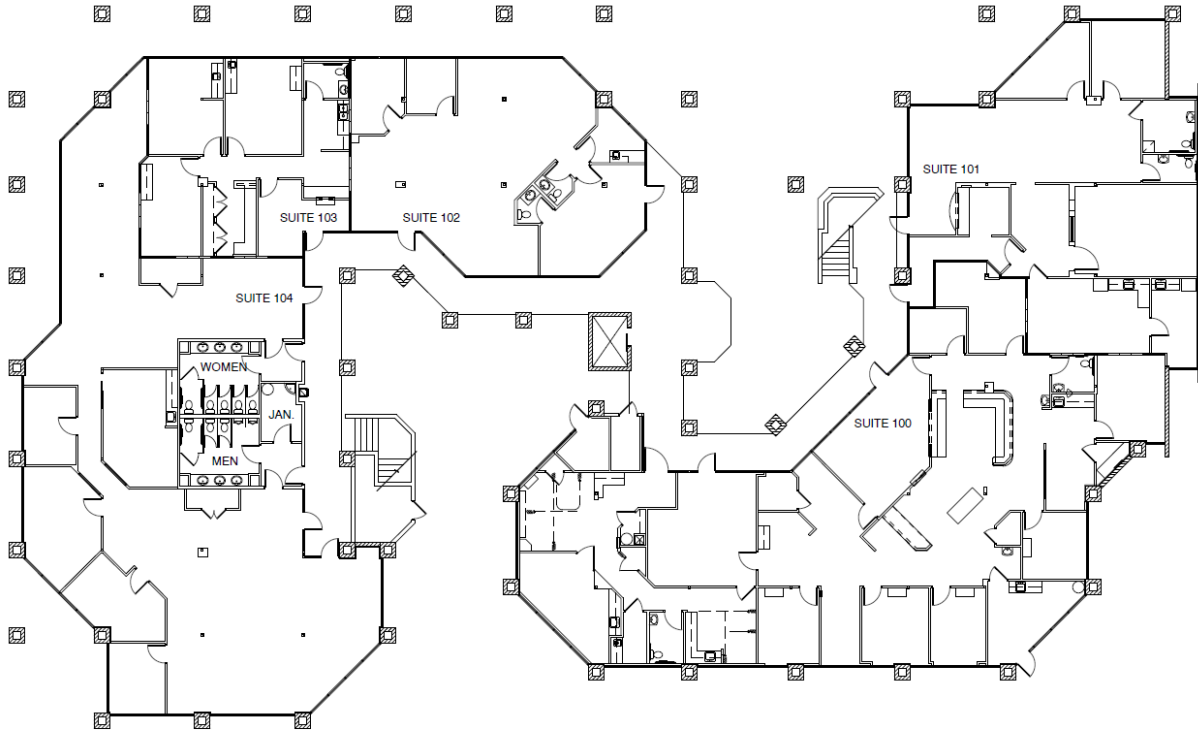

FIRST FLOOR
SCALE: 1/16" = 1'-0"

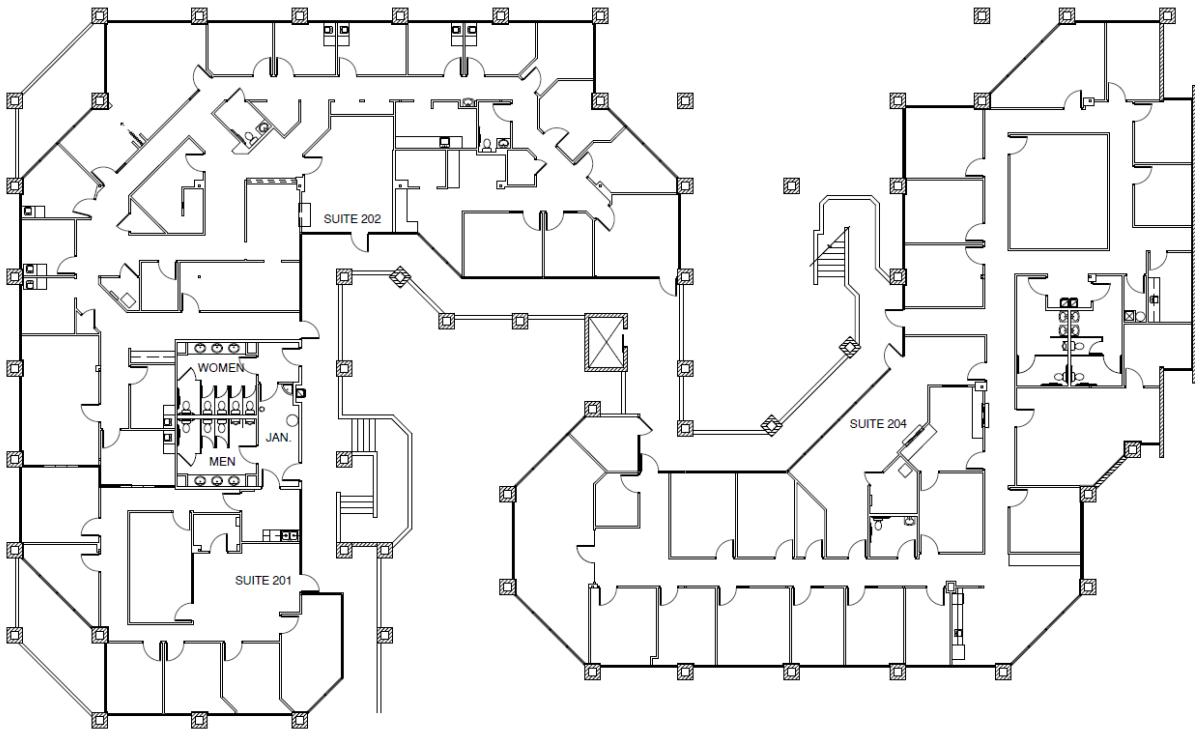

SECOND FLOOR
SCALE: 1/16" = 1'-0"