

NO.	REVISION/ISSUED	DATE


DRAWN BY: F. CANOURA

CHECKED BY:

DATE: 07-24-23

SCALE: AS NOTED

**A1.0**

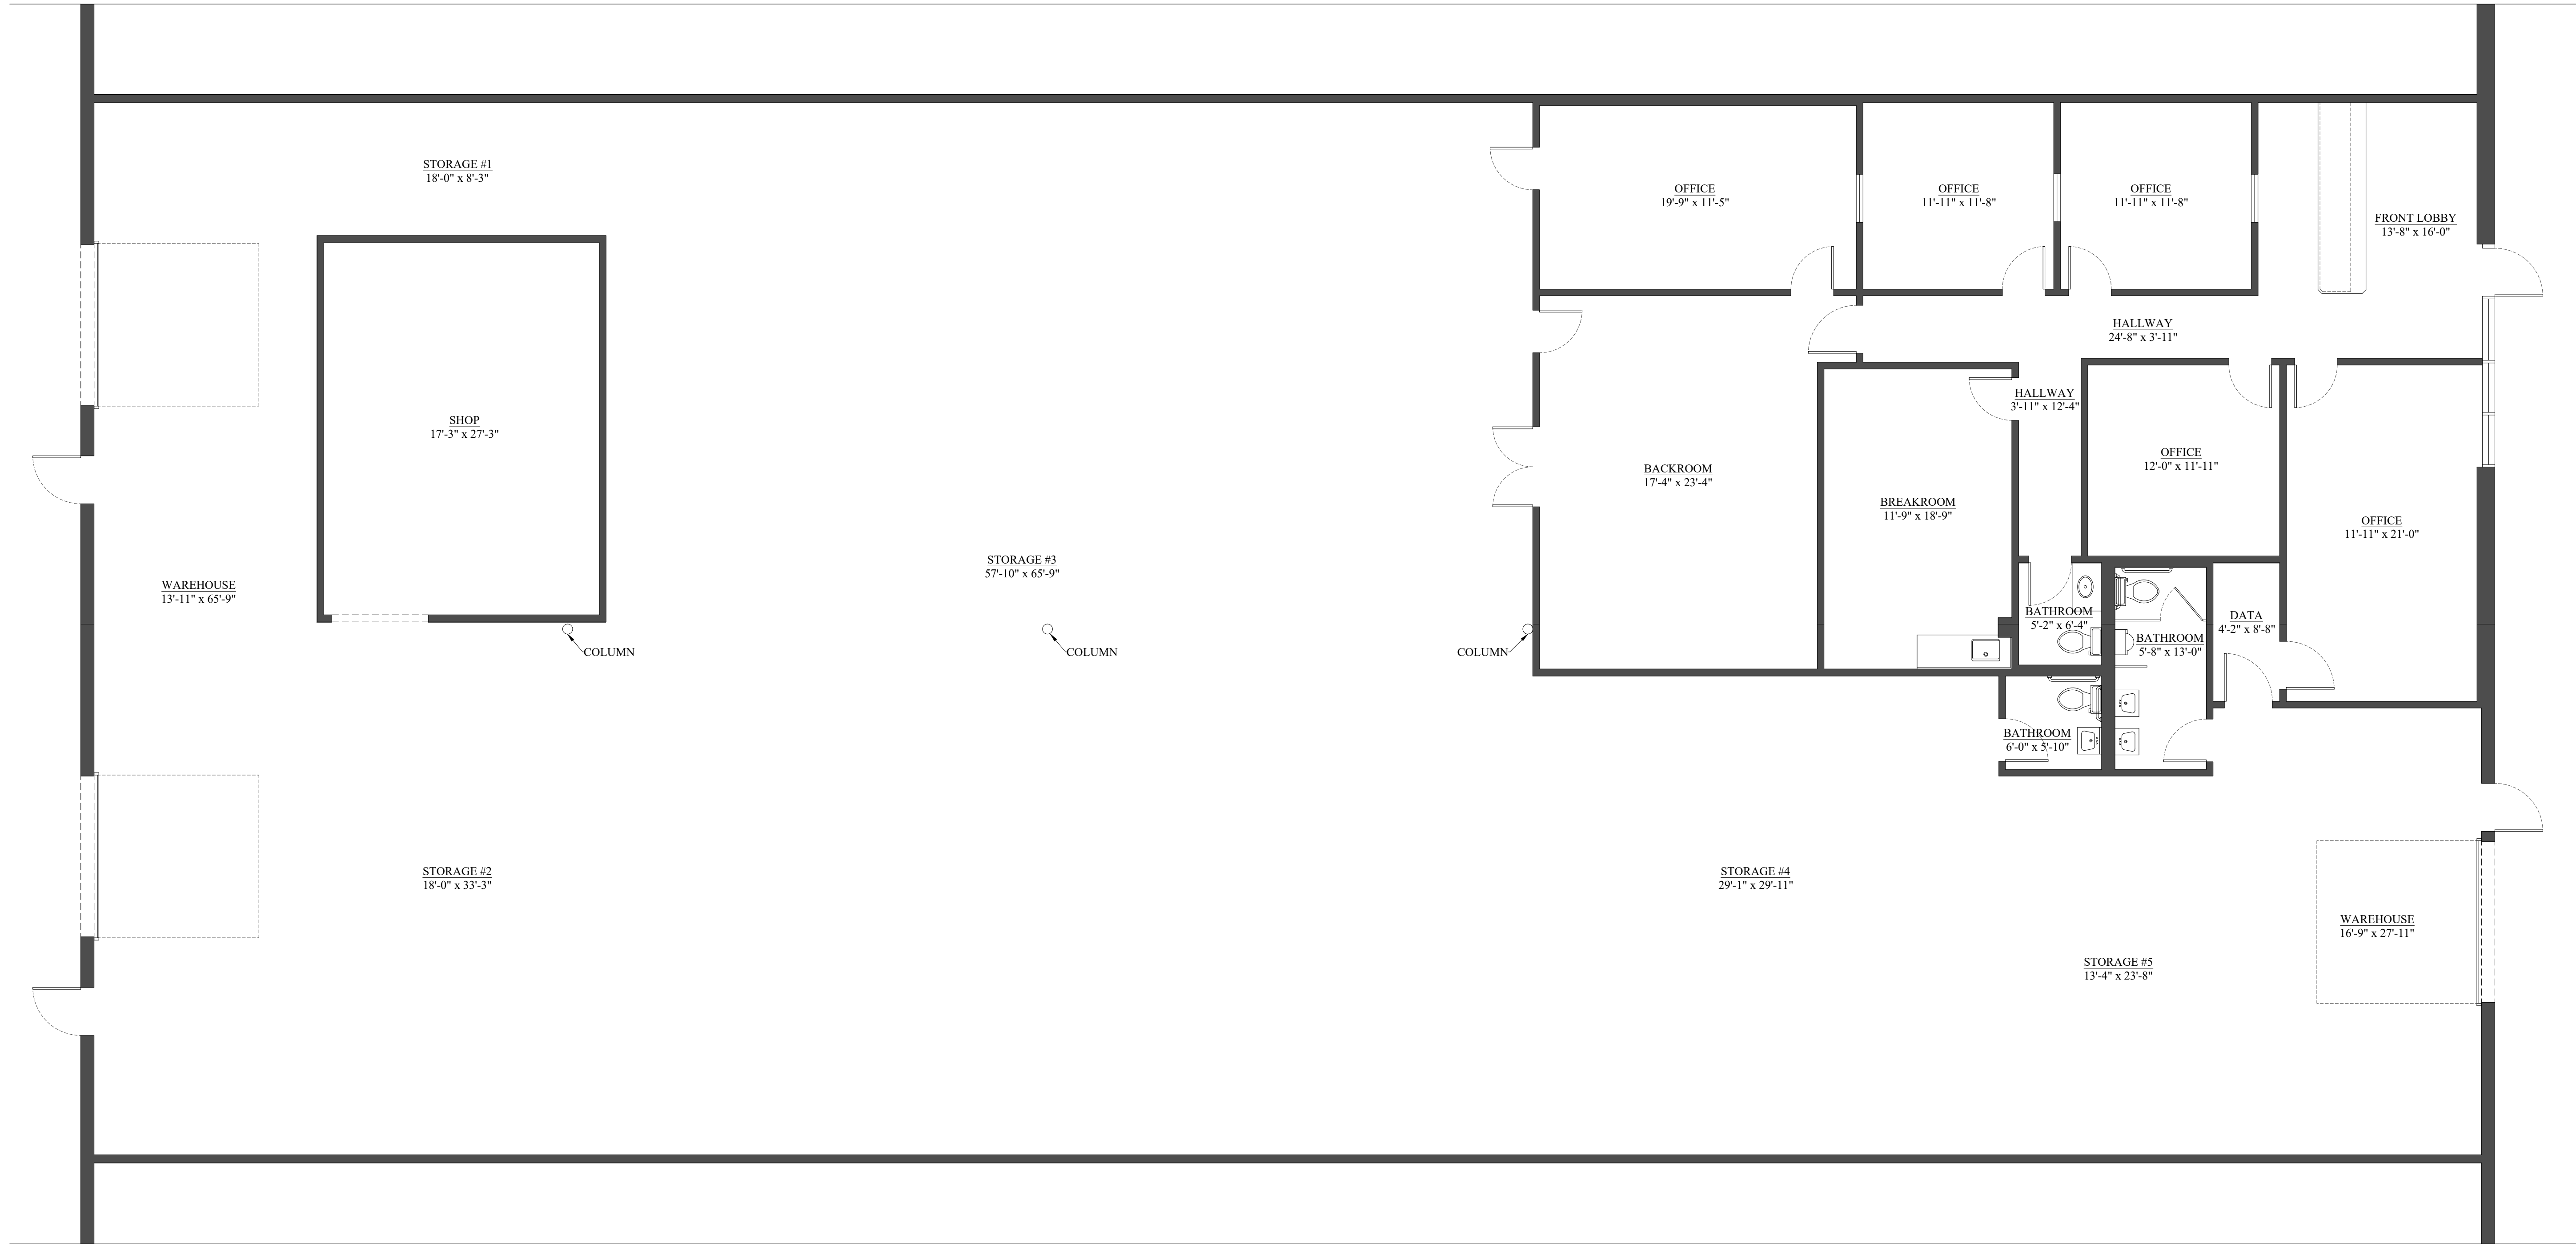

**AS-BUILT FLOOR PLAN**

SCALE: 3/16" = 1'-0"