


15 Spinning Wheel Rd

15 Spinning Wheel Rd
Hinsdale, IL 60521

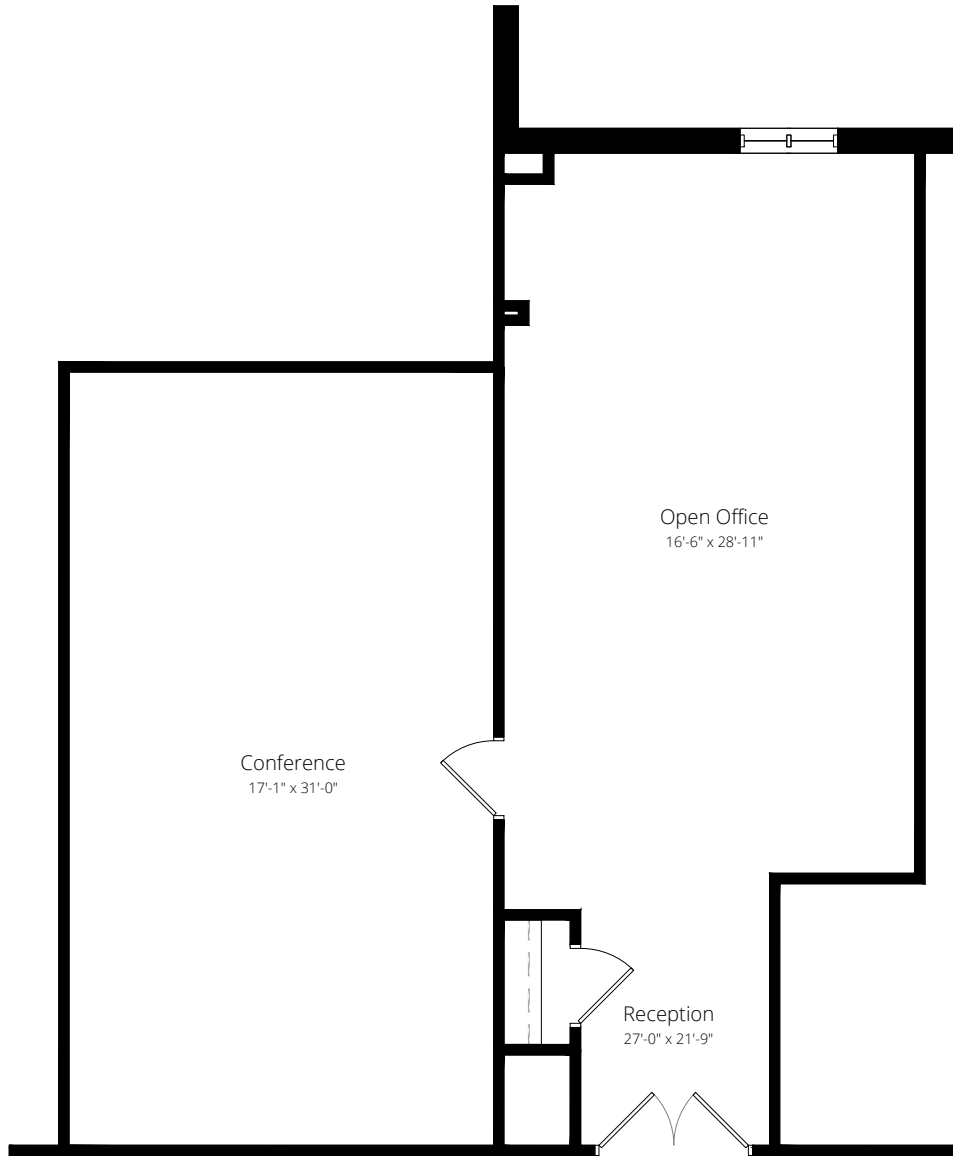

Suite 308 - As-Built Conditions SP-1

1,324 Rentable Square Feet

Scale:

N.T.S.

