


AS-BUILT FLOOR PLAN

SCALE: 1/4" = 1'-0"

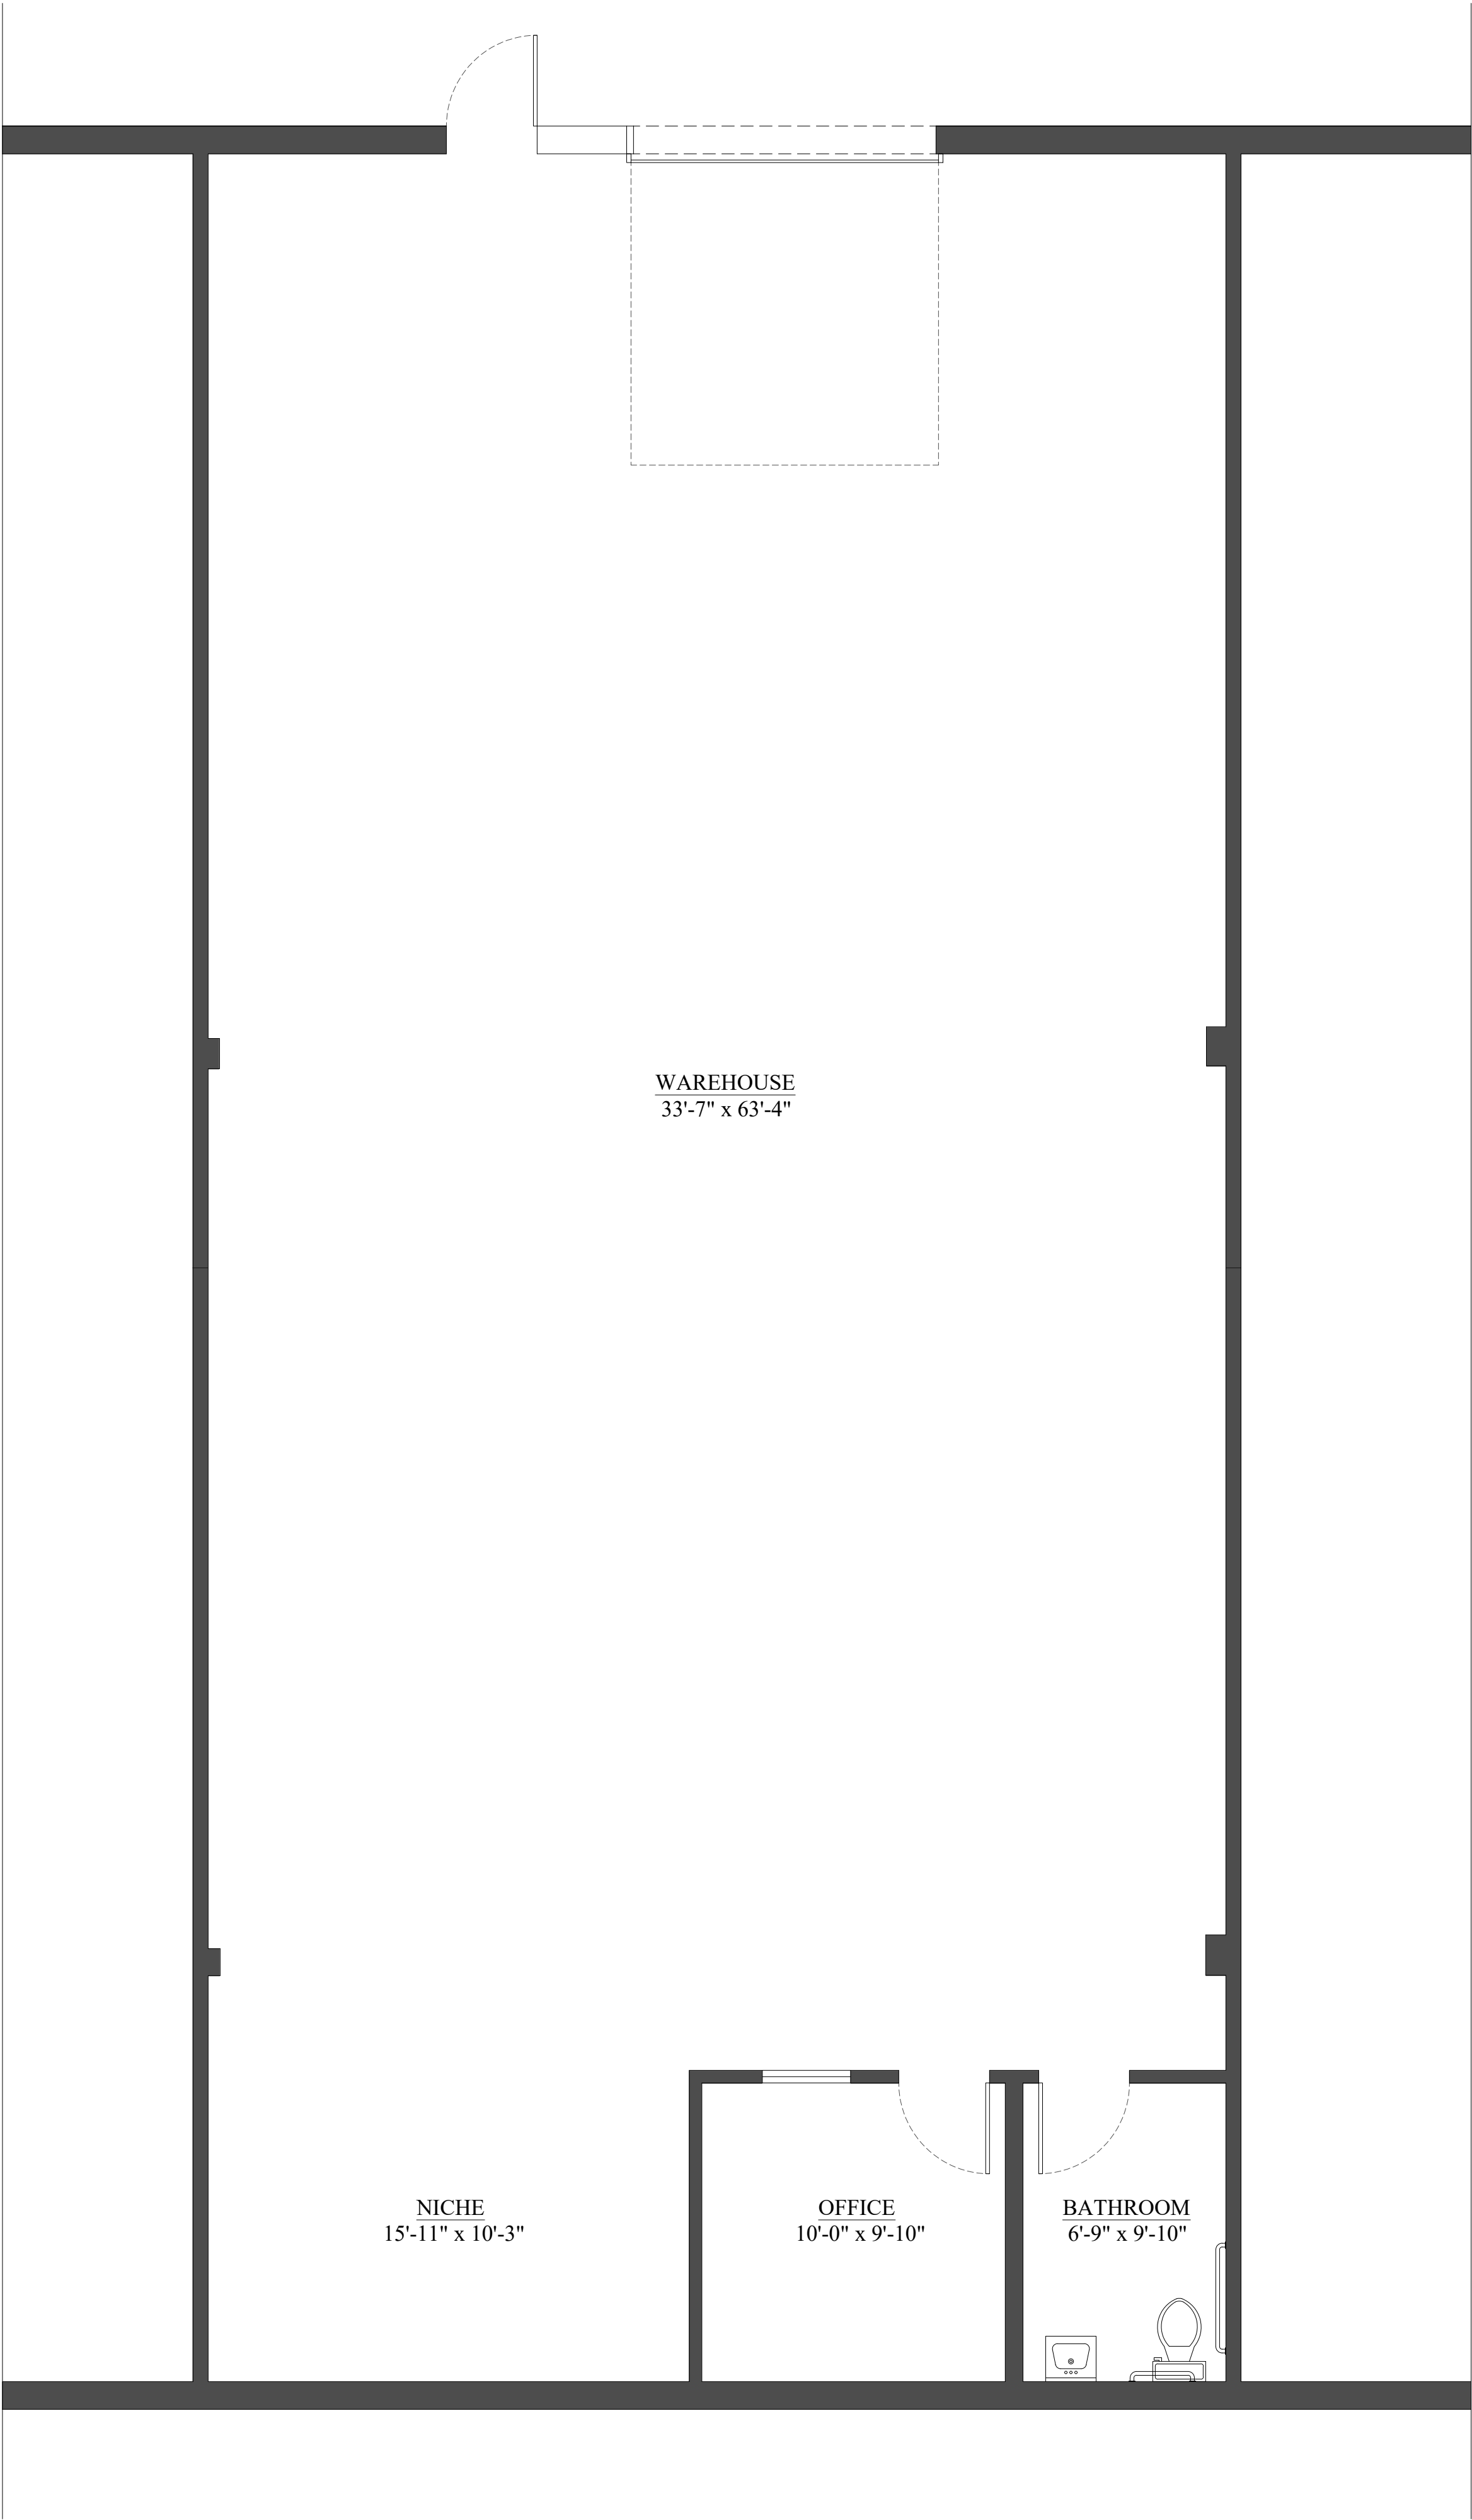

FCD

ARCHITECTURAL DRAFTING AND DESIGNS

CLIENT:

820 BUSINESS PARK

2906 SE LOOP 820, SUITE G
FORT WORTH, TX 76140
PH: (469) 835-7552

PROJECT:

2852B SPACE
EXISTING CONDITION

2852B SE LOOP 820,
FORT WORTH, TX 76140

SHEET TITLE:

AS- BUILT

NO.	REVISION/ISSUED	DATE

DRAWN BY: F. CANOURA

CHECKED BY:

DATE: 09-24-24

SCALE: AS NOTED

A1.0

01 OF 01