


SUITE 1200
AVAILABLE
4357.18 RSF

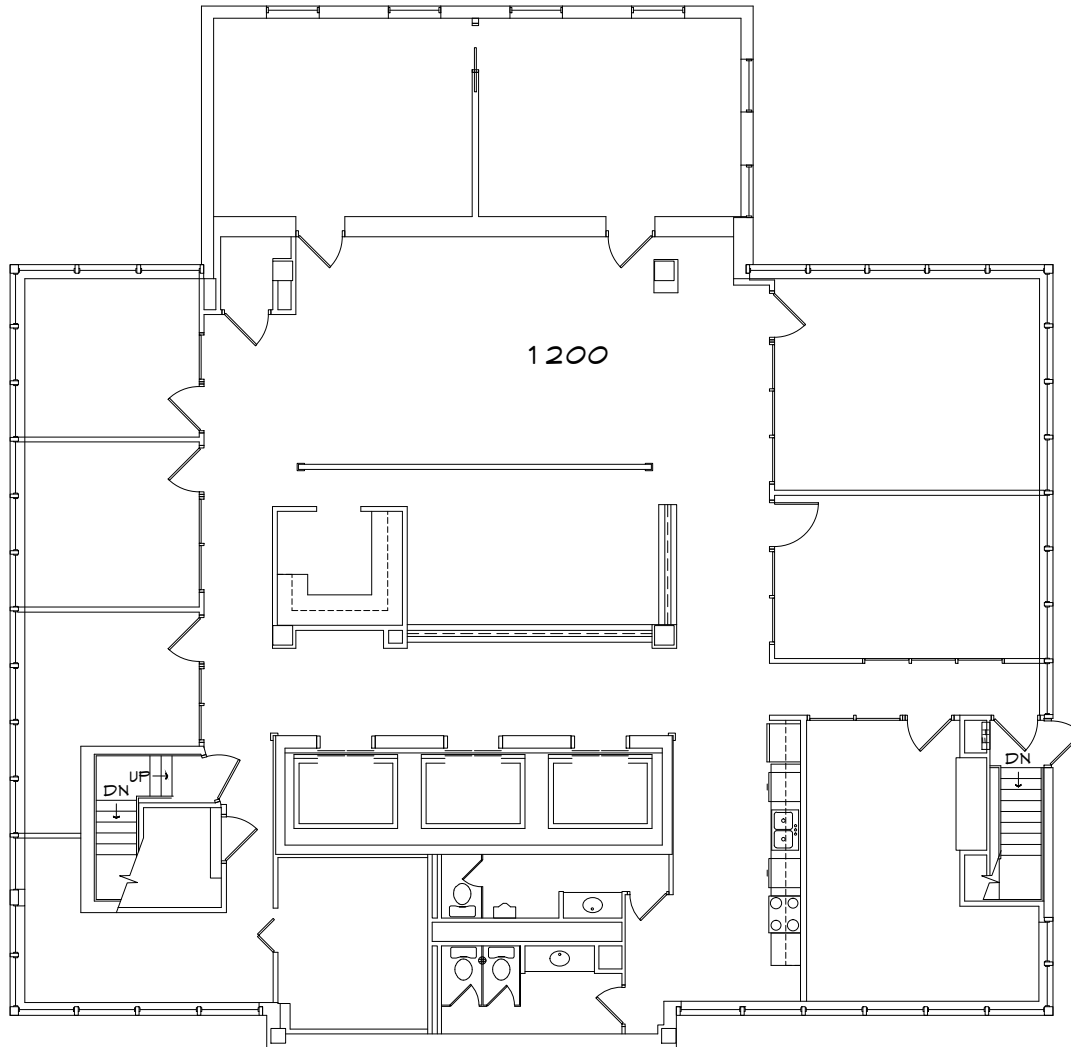

A FLOOR PLAN 
SCALE: N.T.S. NORTH

12TH FLOOR PLAN

SOUTHLAND
TOWER
12TH FLOOR



10.25.2019

AS-BUILT
PLAN

AS.12