

**CENTRAL
PHYSICIANS
PLAZA**


Floor 04

Suite 400A

AS-BUILT

1,725 SF

AVAILABLE

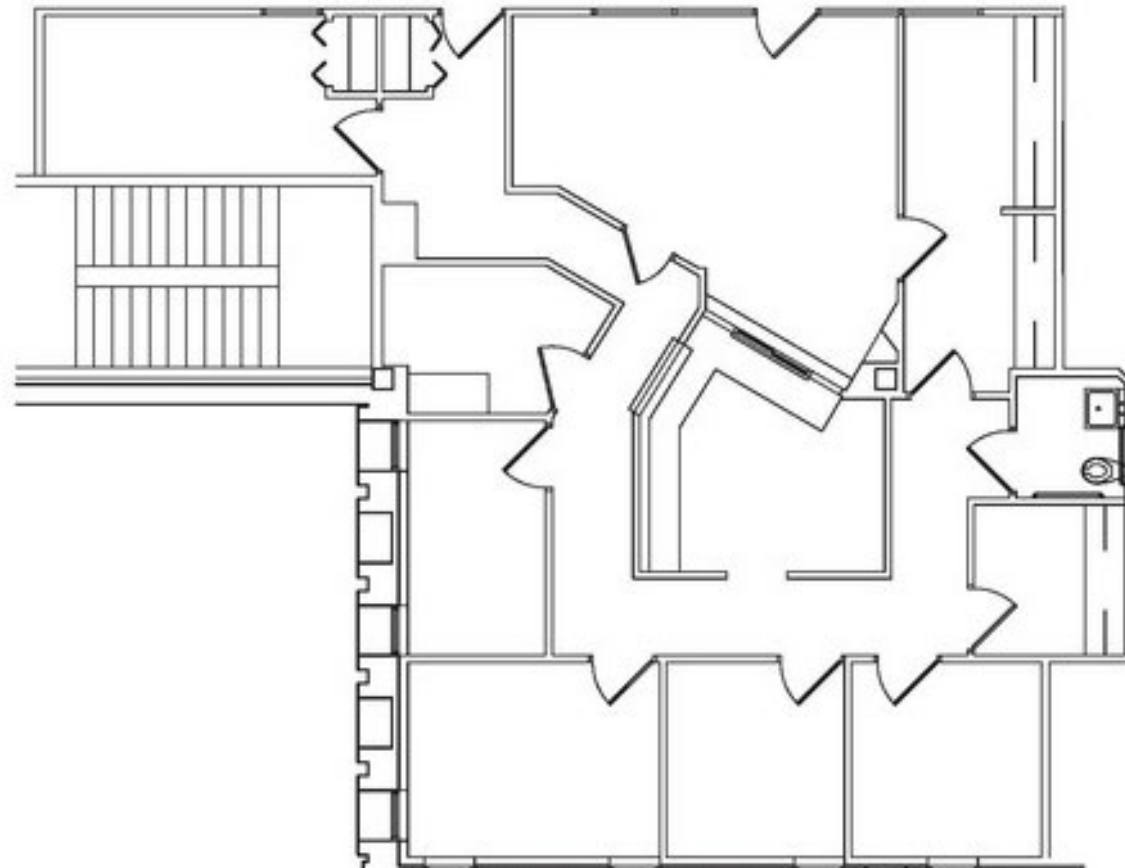

RACHAEL THOMPSON
Senior Vice President
602.513.5122
rachael.thompson@kidder.com

PERRY GABUZZI, CCIM
Senior Vice President
602.513.5116
perry.gabuzzi@kidder.com



View Portfolio