

SUITE 330



AS BUILT- 1 OF 1

BUILDING 5200 - LEVEL THREE

3,199 RSF


SCALE: 1/8" = 1'-0"

DATE: JULY 15, 2026

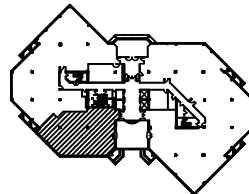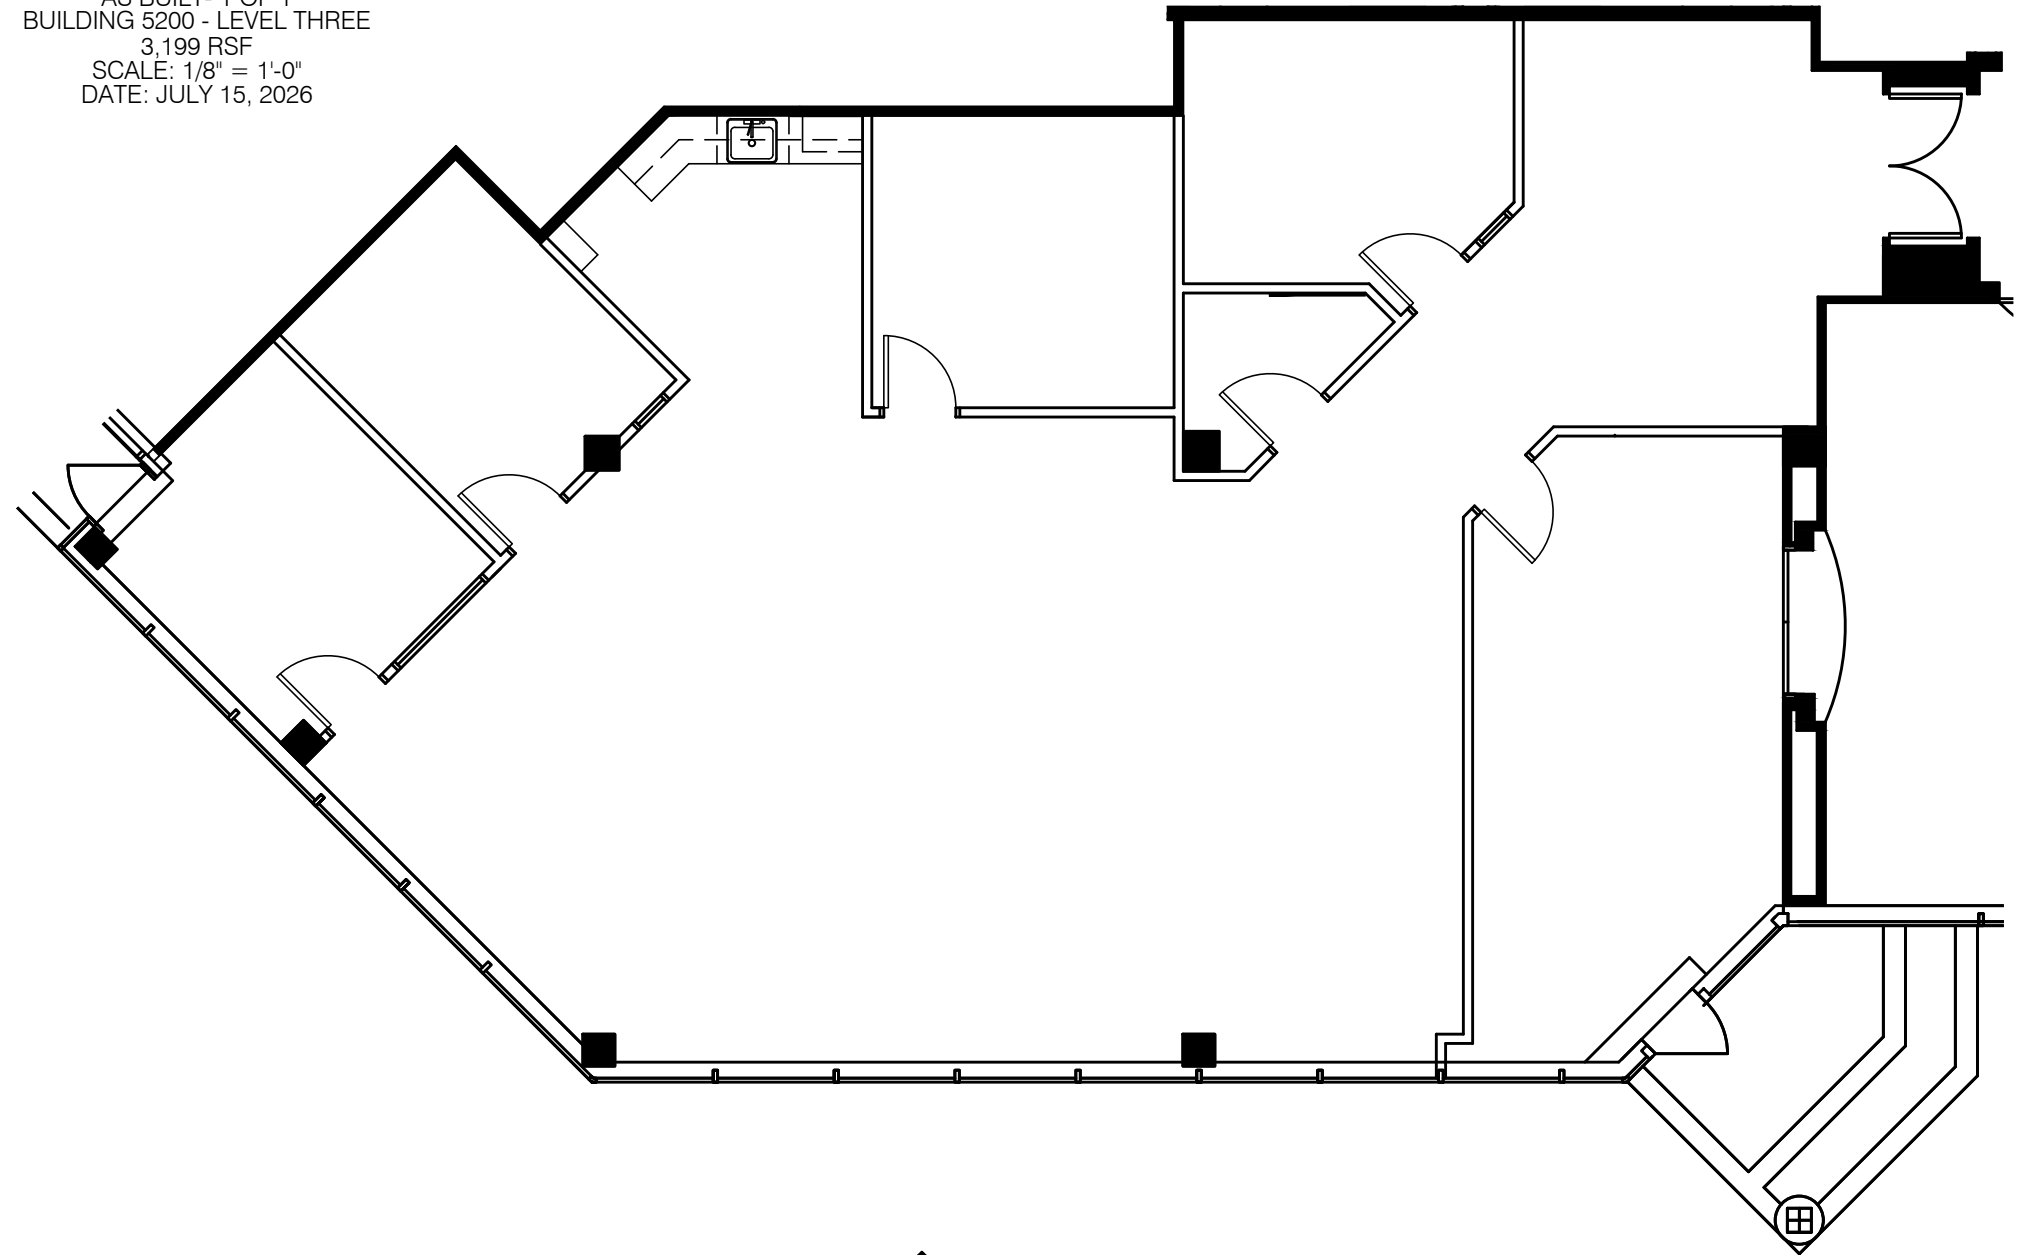

KEY PLAN

CBRE

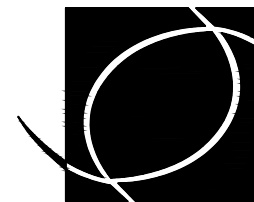

**SMITH
HARRIS
DESIGN**
associates