
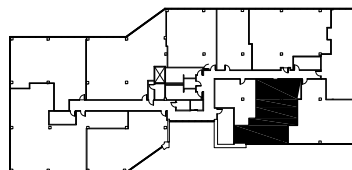


TWIN CENTRAL OFFICE BUILDING

1401 N. Central, Richardson, Texas

SUITE 390

1,364 RSF

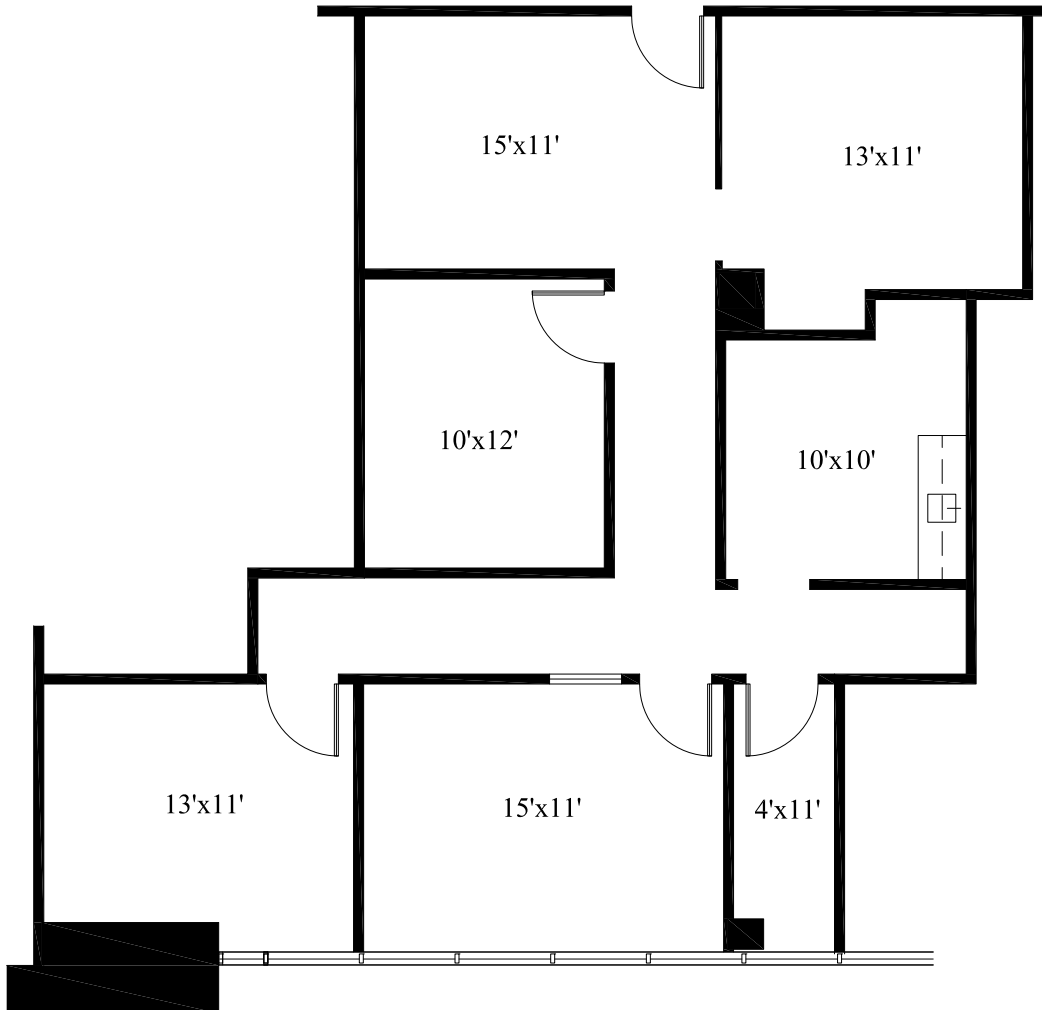

3RD FLOOR

Scale: 1/8"=1'-0"

All dimensions and square footages are approximate.

July 28, 2015



THOMPSON CONSULTING SERVICES, INC.

12024 Golden Meadow Lane, Forney, Texas 75126 (972)564-5252