

TO LET

**RESTAURANT PREMISES
SUITABLE FOR A RANGE OF USES STPP
EXCELLENT TOWN CENTRE LOCATION
380.91 SQ M (4,100 SQ FT)**

59-61 The Broadway, Haywards Heath, RH16 3AS



Summary

Available Size	4,100 sq ft
Rent	£90,000 per annum exclusive
Business Rates	A Rateable Value of £54,000 with a UBR of 55.5 p in £.
EPC Rating	Upon enquiry

Location

Haywards Heath is an affluent commuter town located approximately 15 miles north of Brighton and 14 miles south-east of Crawley and Gatwick Airport. Central London is easily accessed via the mainline railway station, providing a link to London Victoria in approximately 40 minutes. The property is situated in a busy trading area, midway between the prime shopping centre and the town's mainline railway station. There are many substantial office buildings located close by and The Broadway in recent years has been dominated by a variety of food and beverage operators including Pizza Express, Orange Square, La Campana and The Safari Pizza Co.

Description

This characterful building, most recently occupied by Côte Brasserie, offers highly versatile accommodation suitable for a wide range of occupiers. Currently configured as a restaurant, the property benefits from an elegant frontage and a stylish, contemporary interior that can be easily adapted for alternative uses, subject to the necessary planning consents being granted.

The ground floor features an open-plan layout and a welcoming bar area to the left with two interconnecting dining rooms providing seating for approximately 140 guests. The interior includes ceiling-mounted air conditioning and a combination of oak and tiled flooring, a wheelchair-accessible WC is also provided at ground level. The lower ground level is accessed via a staircase to the right of the ground floor, where there is a well-equipped commercial kitchen, including multiple storage areas, and separate ladies', gentlemen's/customer WC facilities.

Externally, the property has previously accommodated outdoor seating for approximately 32 guests. The premises are licensed to sell alcohol seven days a week between 10:00 a.m. and 12:00 a.m. CCTV/Security.

Accommodation

The accommodation comprises the following approximate areas:


Description	sq ft	sq m
Ground Floor	2,300	213.68
Basement	1,800	167.23
Total	4,100	380.91

Lease

The premises is available by way of an assignment of the existing lease which expires in August 2035. The existing Lease includes the self contained flat above which produces circa £12,000 per annum. Interested parties should note that a new lease may be available directly with the Landlord if preferable, more information upon enquiry.

VAT

VAT may be applicable on the terms quoted.

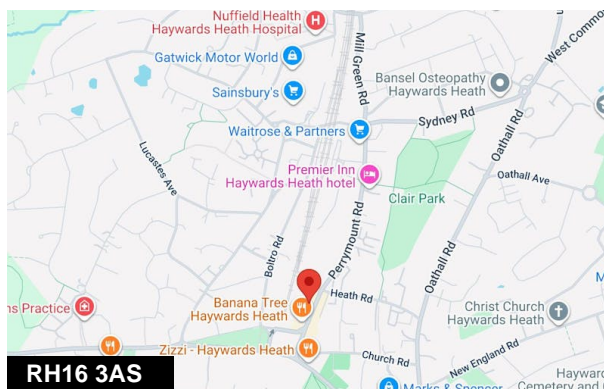

Viewing & Further Information



Alexander Mullett

01444 443400

am@crickmay.co.uk



Phoebe Taylor

01444 443400

pt@crickmay.co.uk

[More details @ crickmay.co.uk](https://www.crickmay.co.uk)



Crickmay Chartered Surveyors

7 Muster Green, Haywards Heath, West Sussex, RH16 4AP


T: 01444 443400 | [crickmay.co.uk](https://www.crickmay.co.uk)

Particulars contained herein are for guidance only and their accuracy is not guaranteed neither do they form any part of a contract. All figures quoted are exclusive of VAT if applicable.





REVISION	DATE	DESCRIPTION
A	15.07.27	BUILDING REGS ON PLAN
B	15.09.17	GREETER STATION

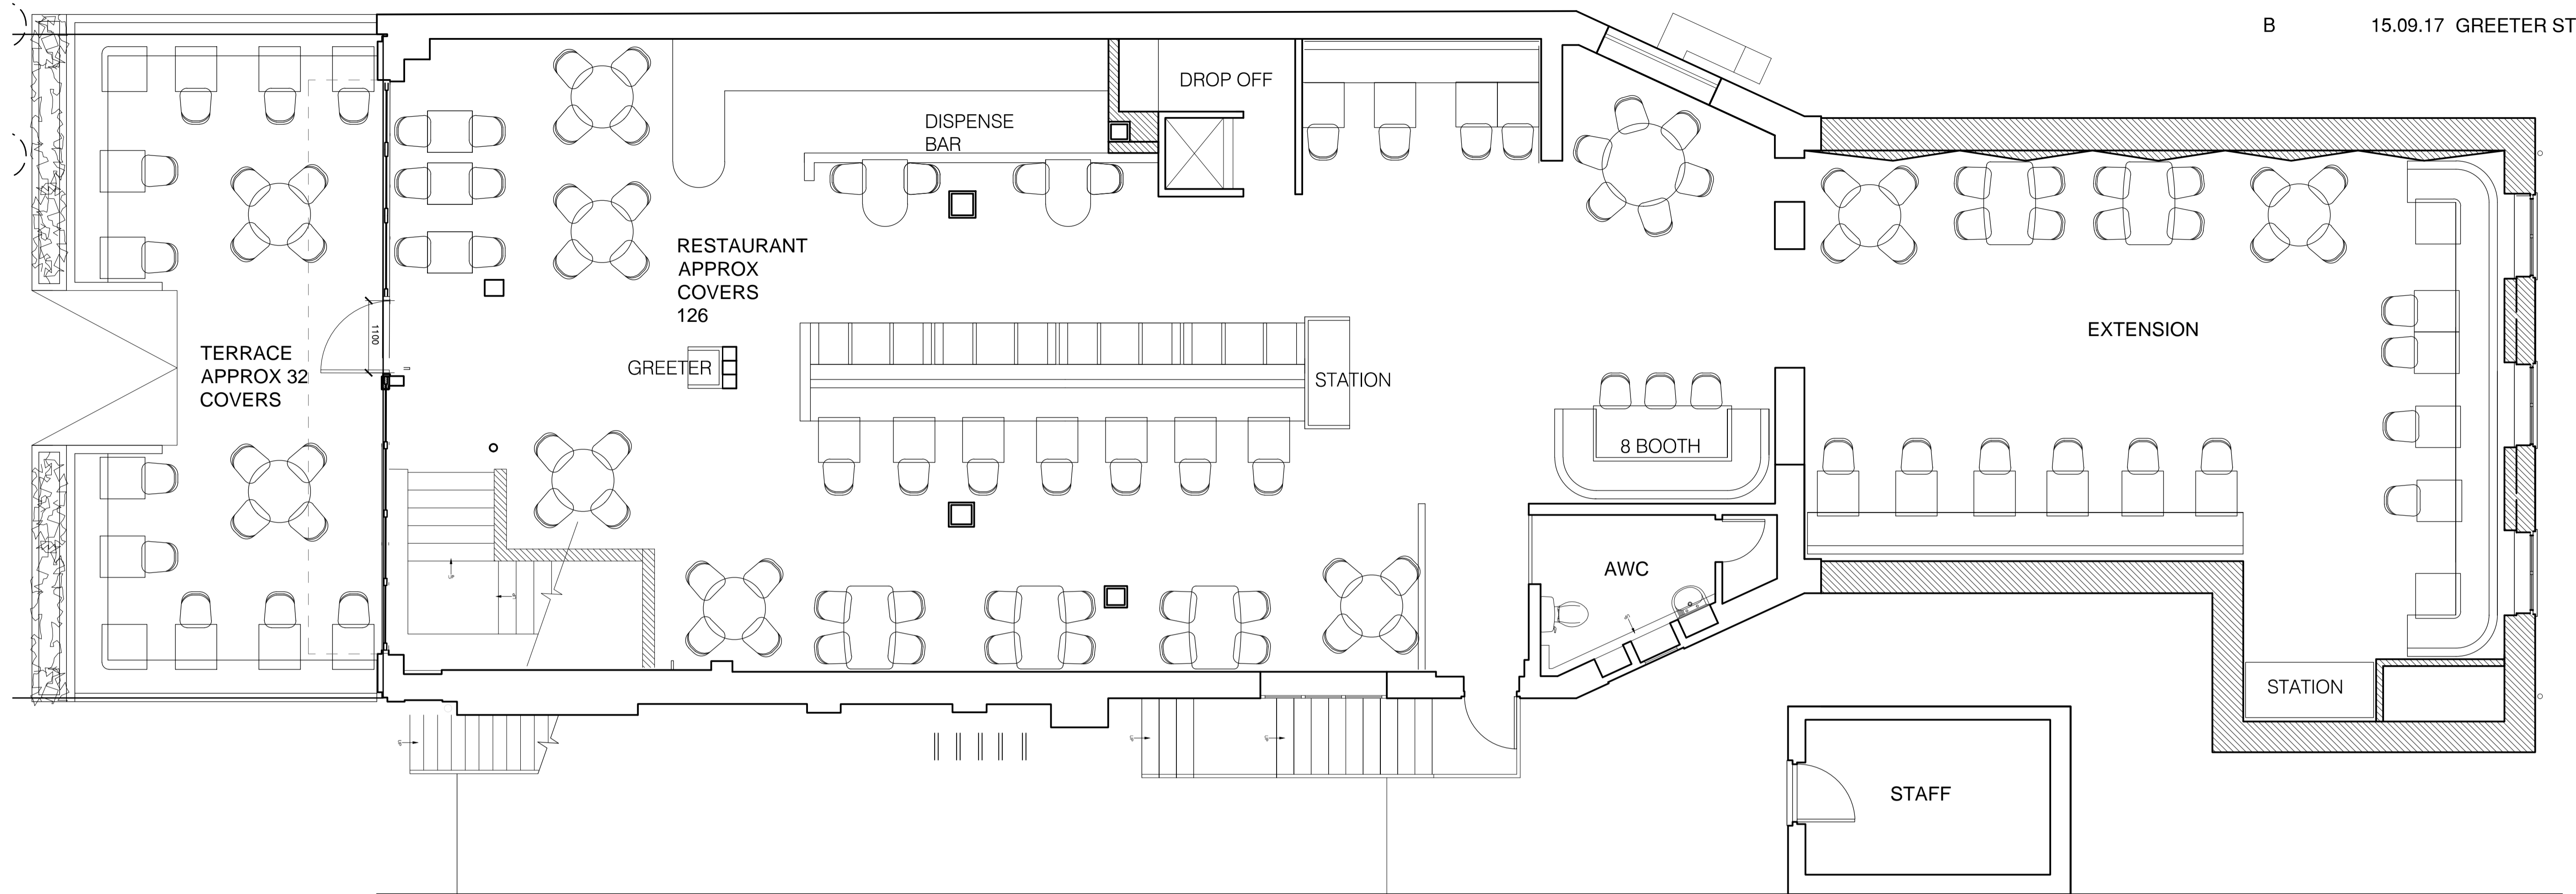

A GROUND FLOOR PLAN
SCALE 1:50@A1

CANTOR CM MASTERS

INTERIOR DESIGN

No1 The Colour House
7 Bell Yard Mews
London SE1 3UA
Tel: +44(0)20 7407 5434
e: info@cantormasters.com
www.cantormasters.com

CLIENT
COTE RESTAURANT


PROJECT
**HAYWARDS HEATH
59-61 THE BROADWAY
RH16 3AS**

TITLE
**GROUND FLOOR
GENERAL ARRANGEMENT PLAN**

JOB No	SCALE	DATE
9015	AS SHOWN	16.06.15
DRAWING No	REVISION	
GA.G.00	B	A1 SHEET


AS BUILT

SCALE @ 1:50

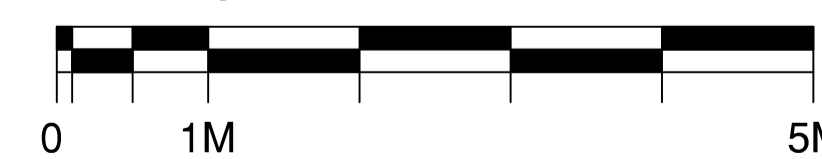

© Copyright is reserved by CantorMasters Ltd.
This drawing is the property of CantorMasters Ltd and is issued on condition that it is not copied in any manner or issued to third parties without the written consent from CantorMasters Ltd. CantorMasters Ltd does not warrant the accuracy of the measurements or other information contained on the drawing and all parties using this drawing and the information contained within must check and verify and satisfy themselves as to the accuracy or otherwise of such measurements or other information.
Do not scale from this drawing. All figured measurements are indicated as a general guide only. All discrepancies or omissions must be reported to CantorMasters Ltd for their comments or approval prior to commencing work.
This drawing to be read in conjunction with all other consultants information and any anomalies reported to CantorMasters Ltd prior to commencement on site.
This drawing is subject to approval by statutory authorities and as such is subject to revision as required.

REVISION	DATE	DESCRIPTION
A	15.07.27	BUILDING REGS ON PLAN
B	15.10.09	GA PLAN UPDATED

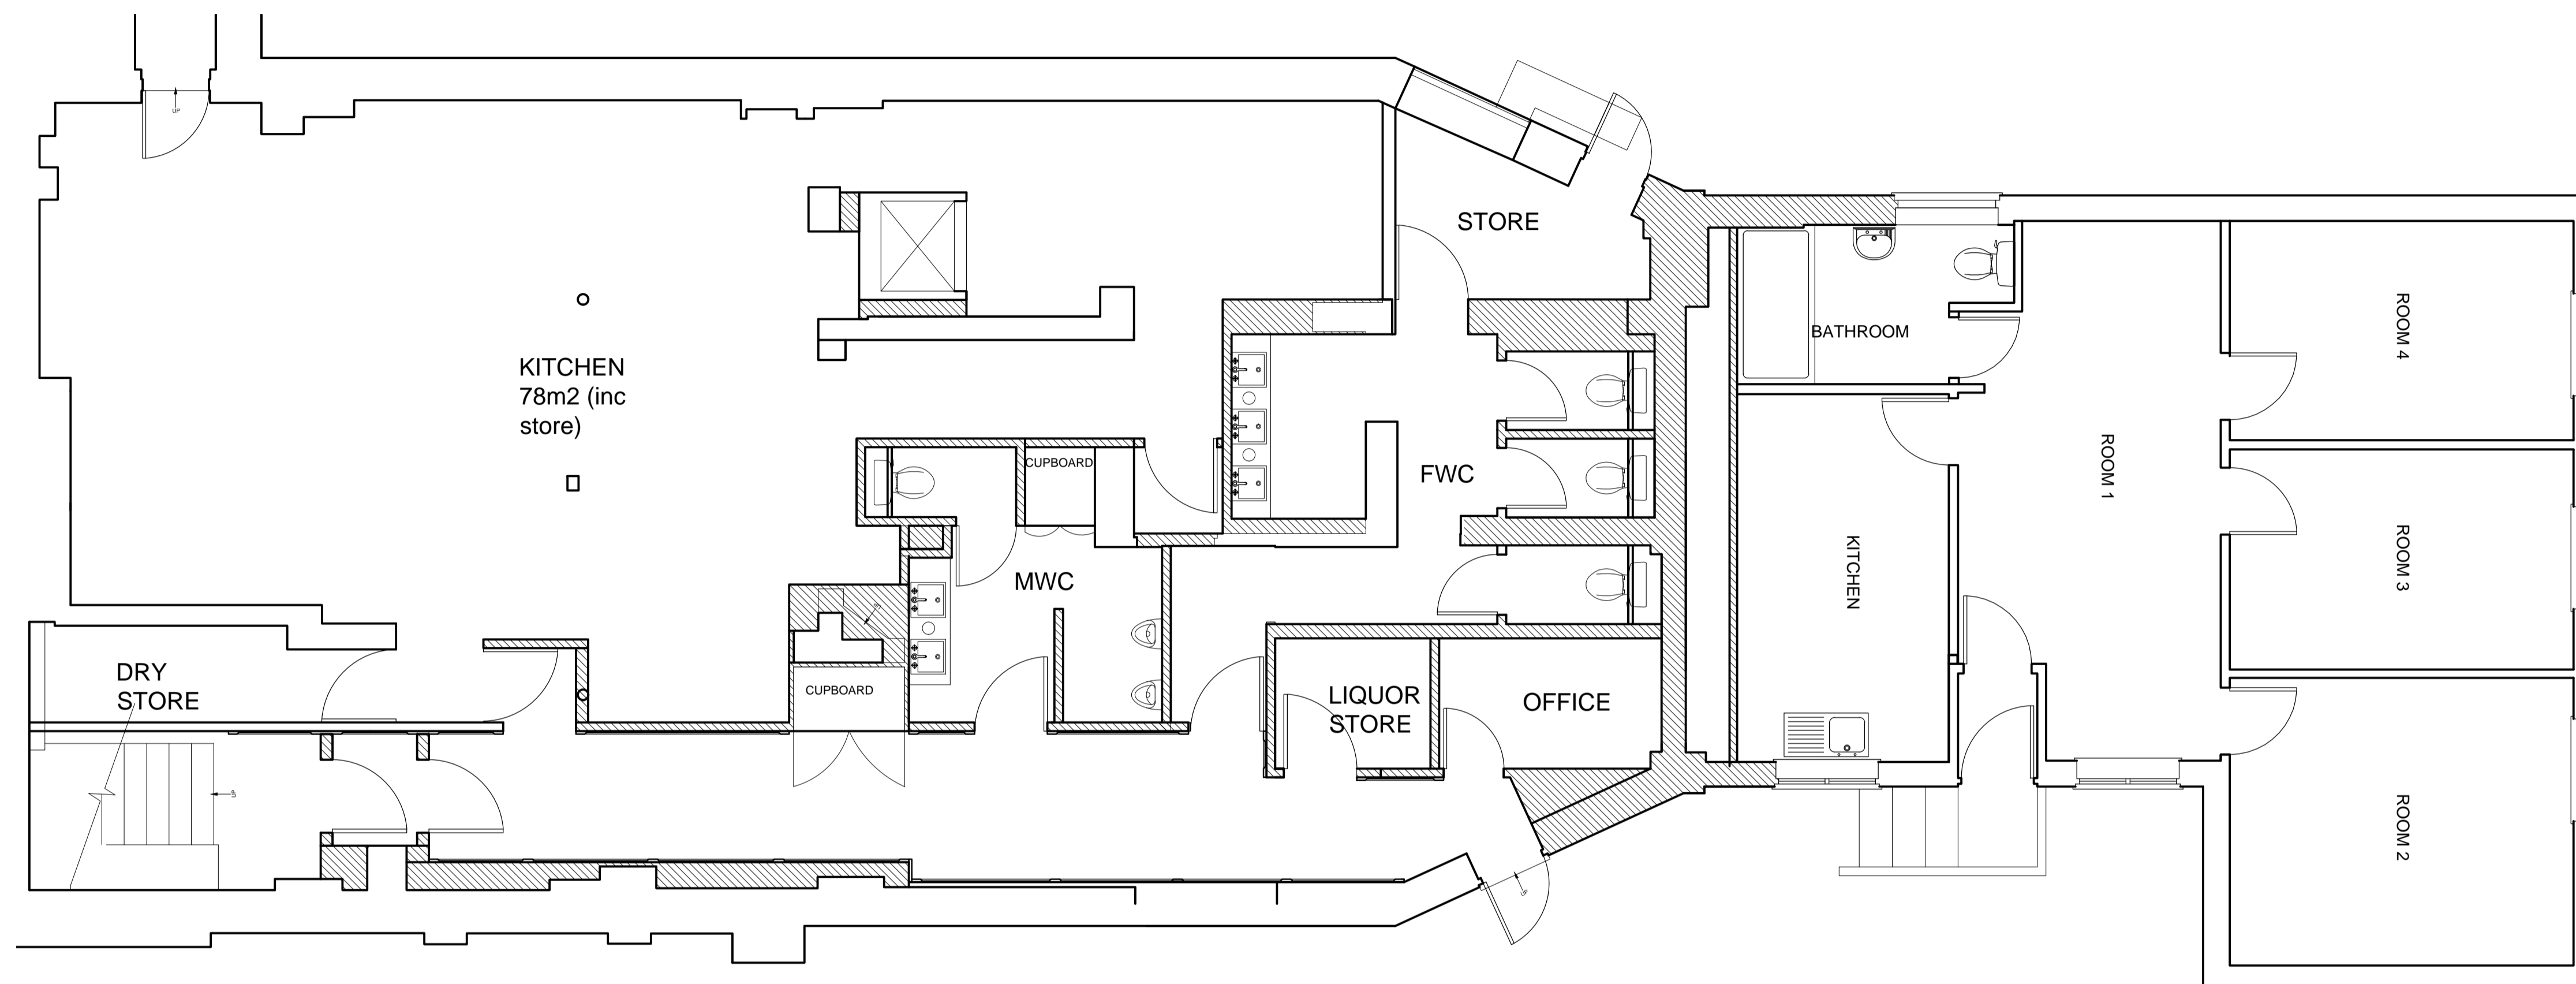

G BASEMENT FLOOR PLAN
SCALE 1:50@A1

CANTOR CM MASTERS

INTERIOR DESIGN

No1 The Colour House
7 Bell Yard Mews
London SE1 3UA
Tel: +44(0)20 7407 5434
e: info@cantormasters.com
www.cantormasters.com

CLIENT
COTE RESTAURANT


PROJECT
**HAYWARDS HEATH
59-61 THE BROADWAY
RH16 3AS**

TITLE
**BASEMENT FLOOR
GENERAL ARRANGEMENT PLAN**

JOB No	SCALE	DATE
9015	AS SHOWN	16.06.15
DRAWING No	REVISION	
GA.B.00	B	A1 SHEET

AS BUILT

SCALE @ 1:50

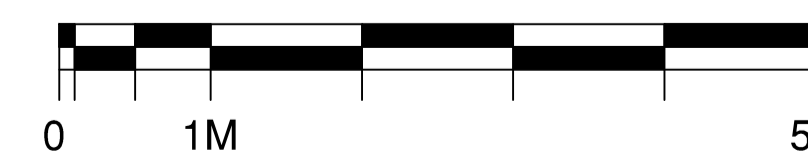

© Copyright is reserved by CantorMasters Ltd.
This drawing is the property of CantorMasters Ltd and is issued on condition that it is not copied in any manner or issued to third parties without the written consent from CantorMasters Ltd. CantorMasters Ltd does not warrant the accuracy of the measurements or other information contained on the drawing and all parties using this drawing and the information contained within must check and verify and satisfy themselves as to the accuracy or otherwise of such measurements or other information.
Do not scale from this drawing. All figured measurements are indicated as a general guide only. All discrepancies or omissions must be reported to CantorMasters Ltd for their comments or approval prior to commencing work.
This drawing to be read in conjunction with all other consultants information and any anomalies reported to CantorMasters Ltd prior to commencement on site.
This drawing is subject to approval by statutory authorities and as such is subject to revision as required.