
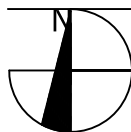


1512 West Bell Road

Phoenix . Arizona

Suite 3 - 900 SF

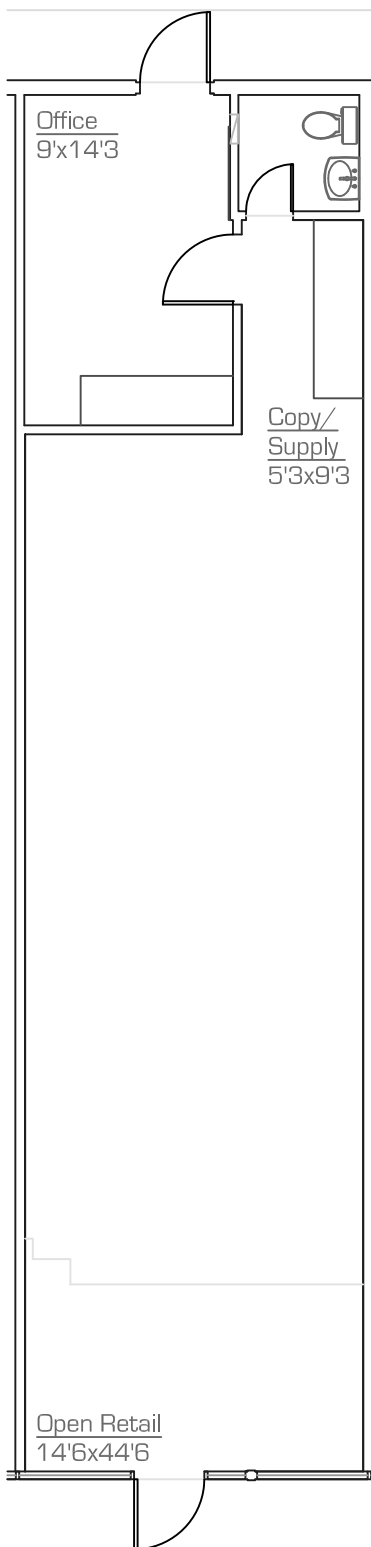

As-Built

scale: nts

11.February.2016

*All dimensions are approximate at $\pm 3"$

*All information is of general nature

precision**DIMENSIONS**

as-built & design
602. 790. 6412

