

GRANITE
VALLEY
MEDICAL
OFFICE

14506 W GRANITE VALLEY DR | SUN CITY WEST, AZ 85375


Floor 2

Suite 217

AS-BUILT

1,049 SF

AVAILABLE

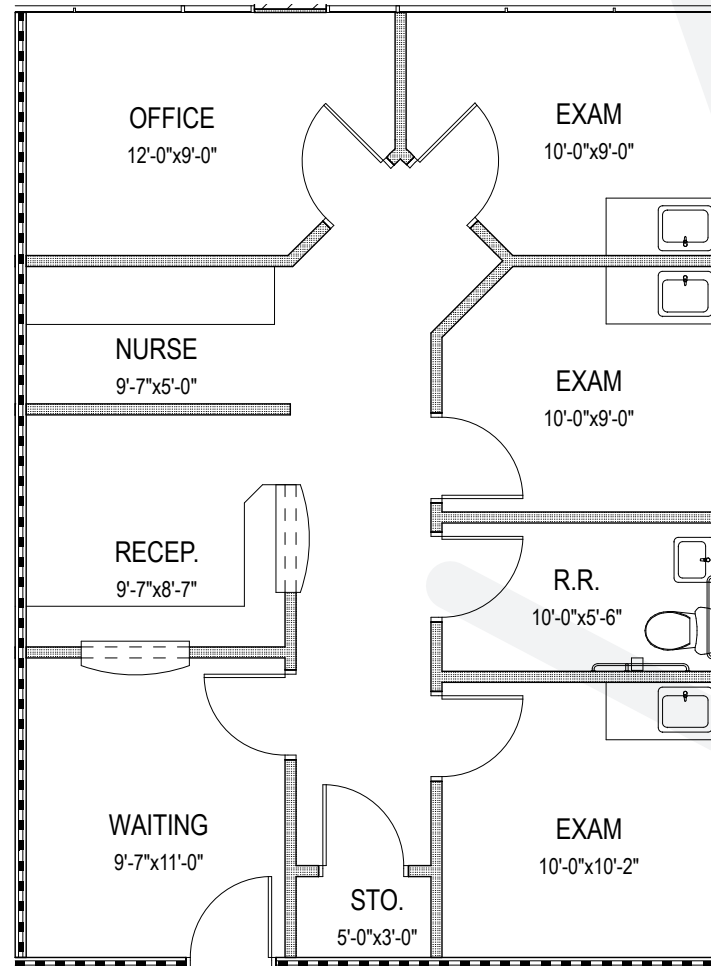

RACHAEL THOMPSON
Senior Vice President
602.513.5122
rachael.thompson@kidder.com

PERRY GABUZZI, CCIM
Senior Vice President
602.513.5116
perry.gabuzzi@kidder.com