





THE CENTRUM

SUITE 505
FLOOR PLAN
4,231 RSF

AS-BUILT PLAN

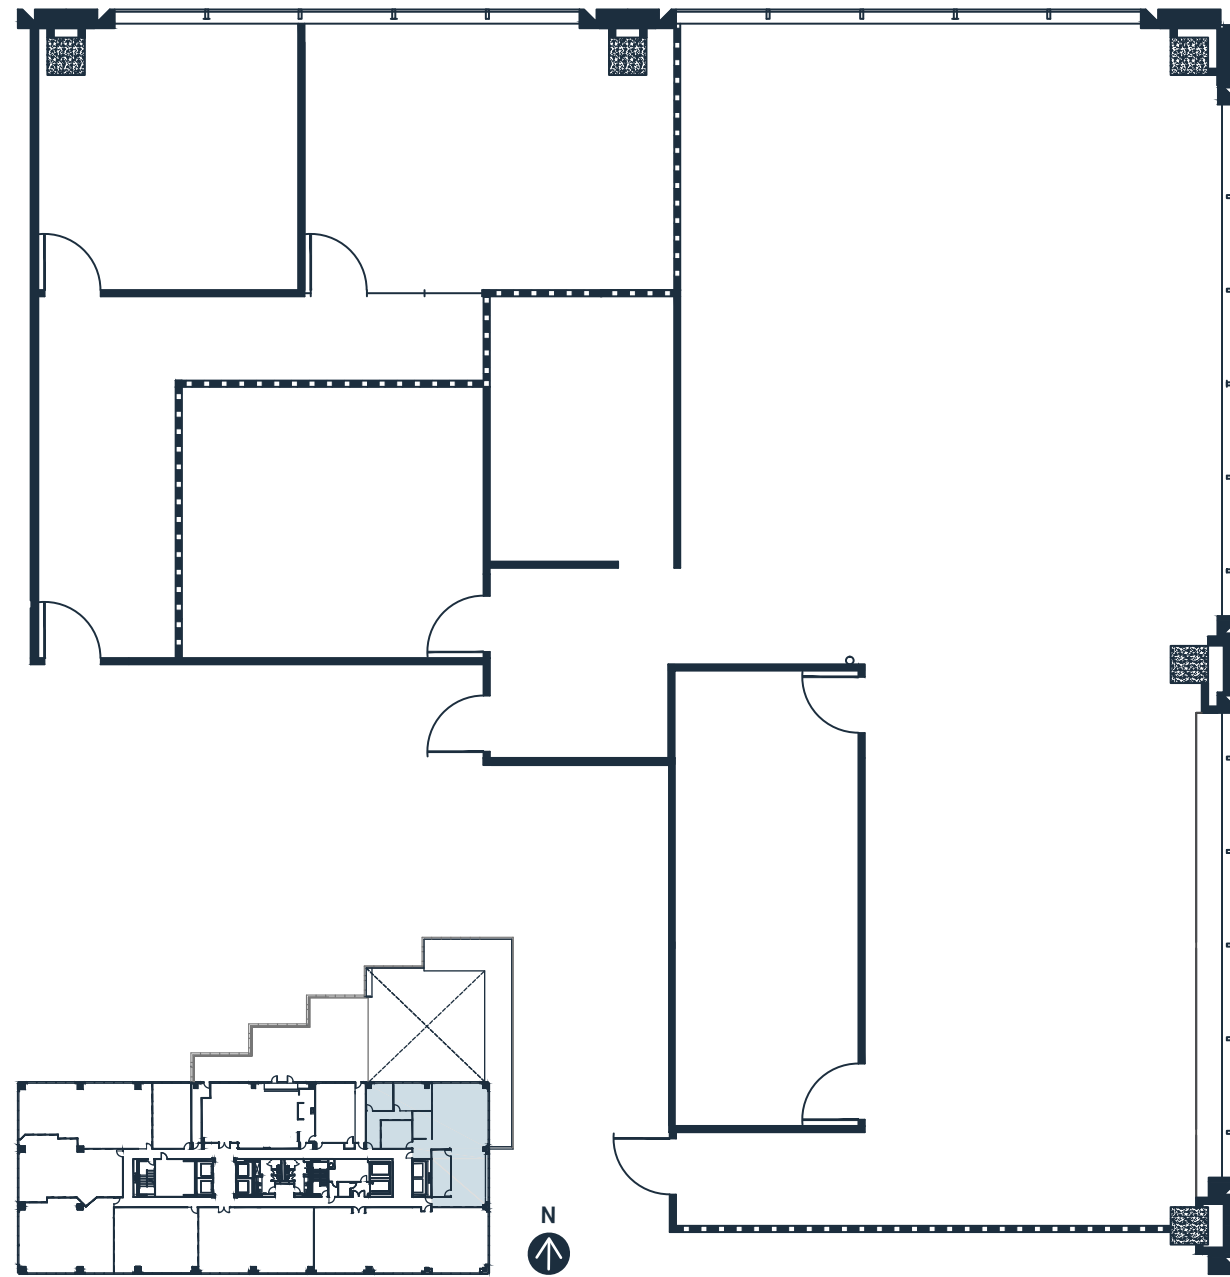

HYPOTHETICAL PLAN

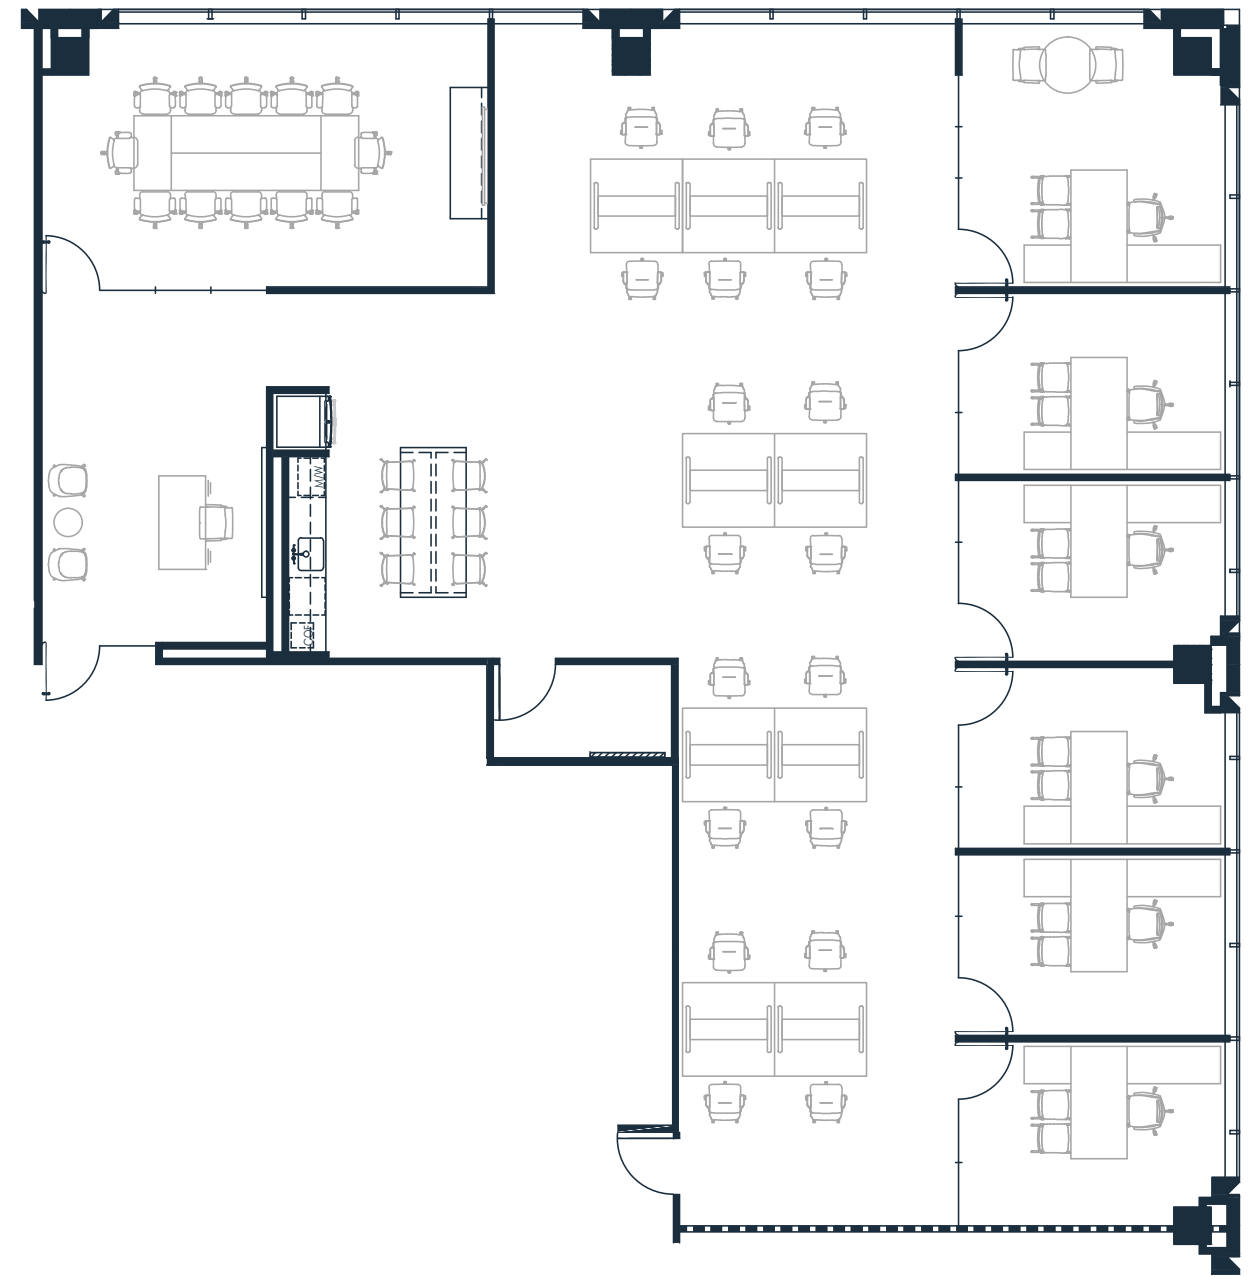

FOR LEASING INFORMATION CONTACT:

ADDIE LUDWIG
972.759.7727
aludwig@cawleypartners.com

JEREMY DUGGINS
972.759.7716
jduggins@cawleypartners.com

KRISTI WADDELL
972.759.7711
kwaddell@cawleypartners.com



OFFICE