

Available Suites

1528 E WILLIAMS FIELD RD

SUITE 202: $\pm 8,176$ SF¹ (AVAILABLE 03/01/2027)

SUITE 205: $\pm 6,403$ SF¹ $\pm 14,579$ SF

¹CONTIGUOUS TO $\pm 14,579$ SF | \$32.00 SF NNN

AS-BUILT FLOOR PLAN




Available Suites

1528 E WILLIAMS FIELD RD

SUITE 202: ±8,176 SF¹ (AVAILABLE 03/01/2027) | \$32.00 SF NNN | ¹CONTIGUOUS TO ±14,579 SF

AS-BUILT FLOOR PLAN

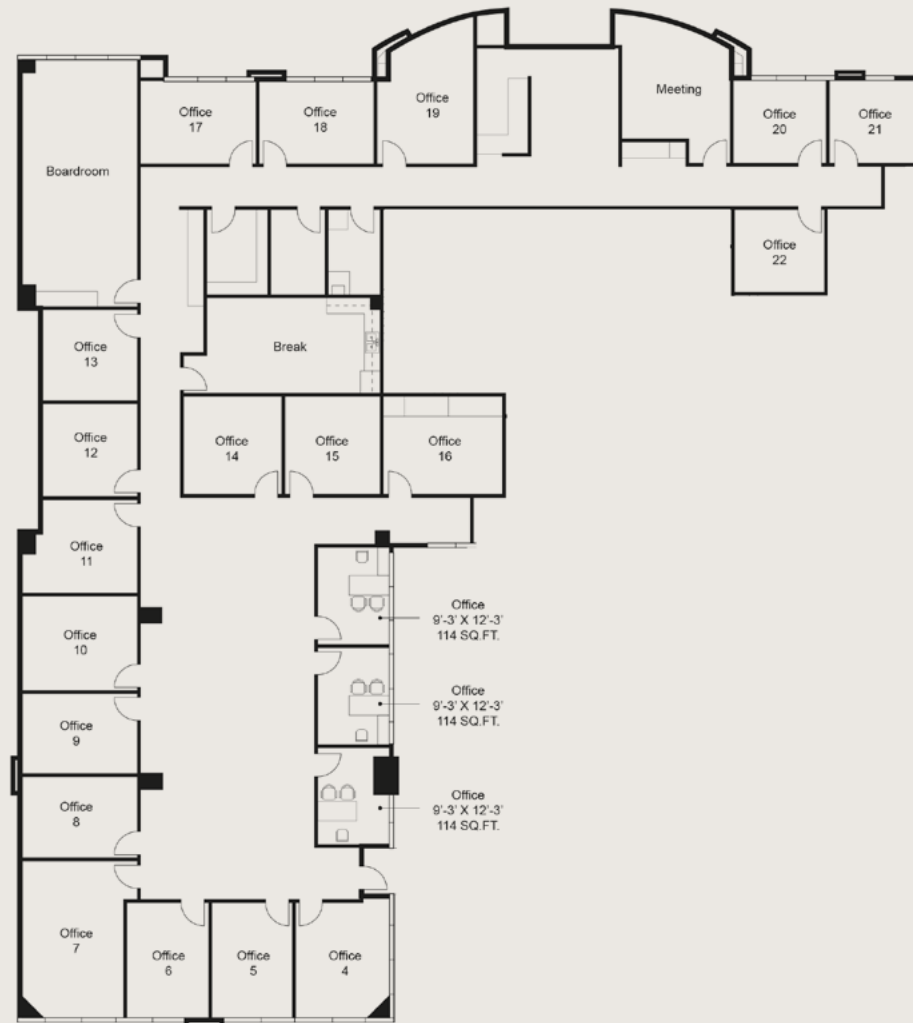


Available Suites


1528 E WILLIAMS FIELD RD

SUITE 205: $\pm 6,403$ SF¹ | \$32.00 SF NNN | ¹CONTIGUOUS TO $\pm 14,579$ SF

AS-BUILT FLOOR PLAN

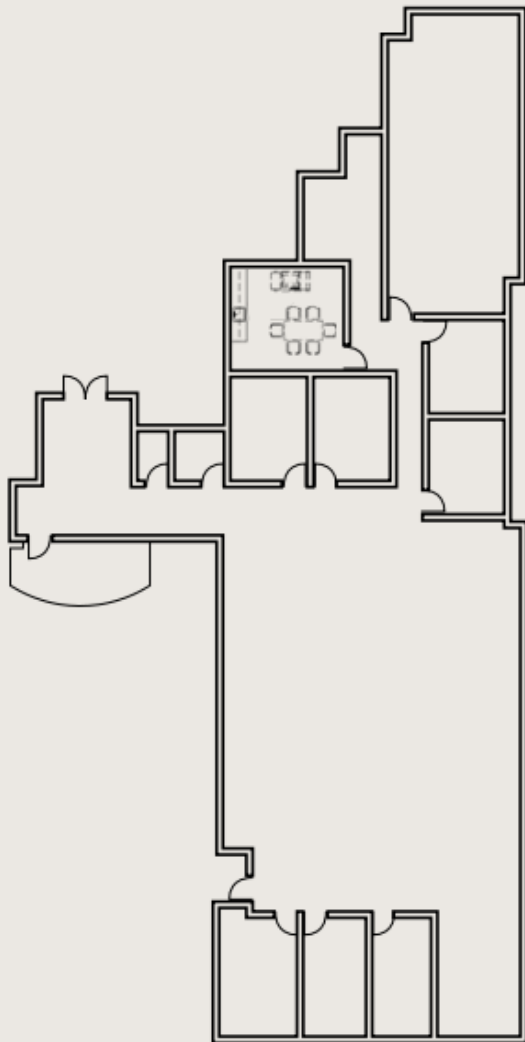

CONCEPTUAL FLOOR PLAN

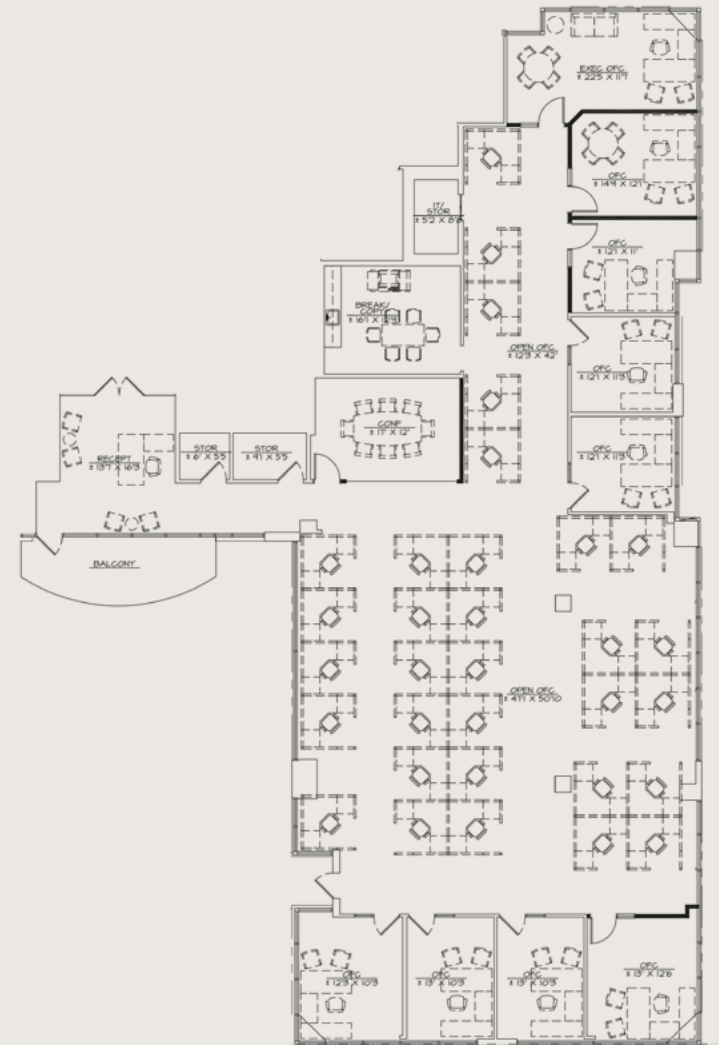

[Click Here For Virtual Tour](#)




Available Suites


1530 E WILLIAMS FIELD RD

SUITE 206: ±1,688 SF (AVAILABLE 08/01/2026) | \$32.00 SF NNN

AS-BUILT FLOOR PLAN

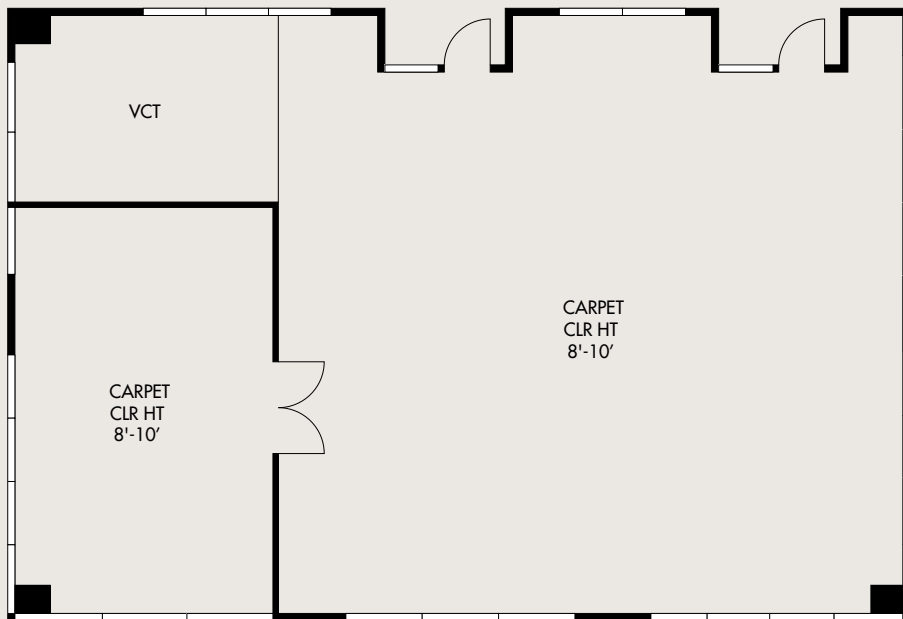

CONCEPTUAL FLOOR PLAN

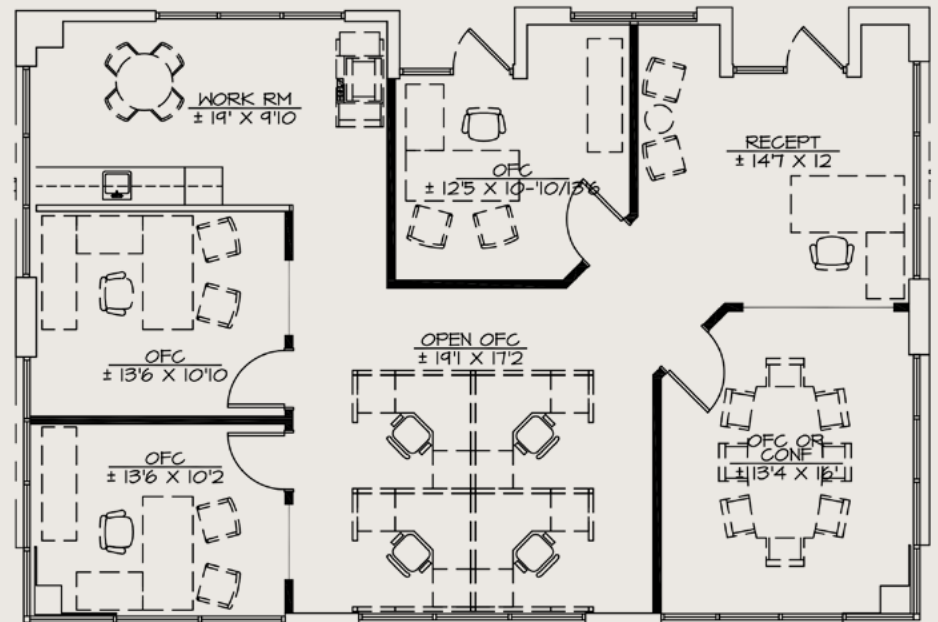

Available Suites

1530 E WILLIAMS FIELD RD

SUITE 210: ±4,293 SF (AVAILABLE 08/01/2026) | \$32.00 SF NNN

AS-BUILT FLOOR PLAN

