


1st FLOOR PLAN

A/C AREA	1,359 SF
front porches	236 SF
rear ramp/landing	126 SF

1/8" = 1'-0"

AS-BUILT DRAWINGS

635 S. PRESA
San Antonio, TX. 78210

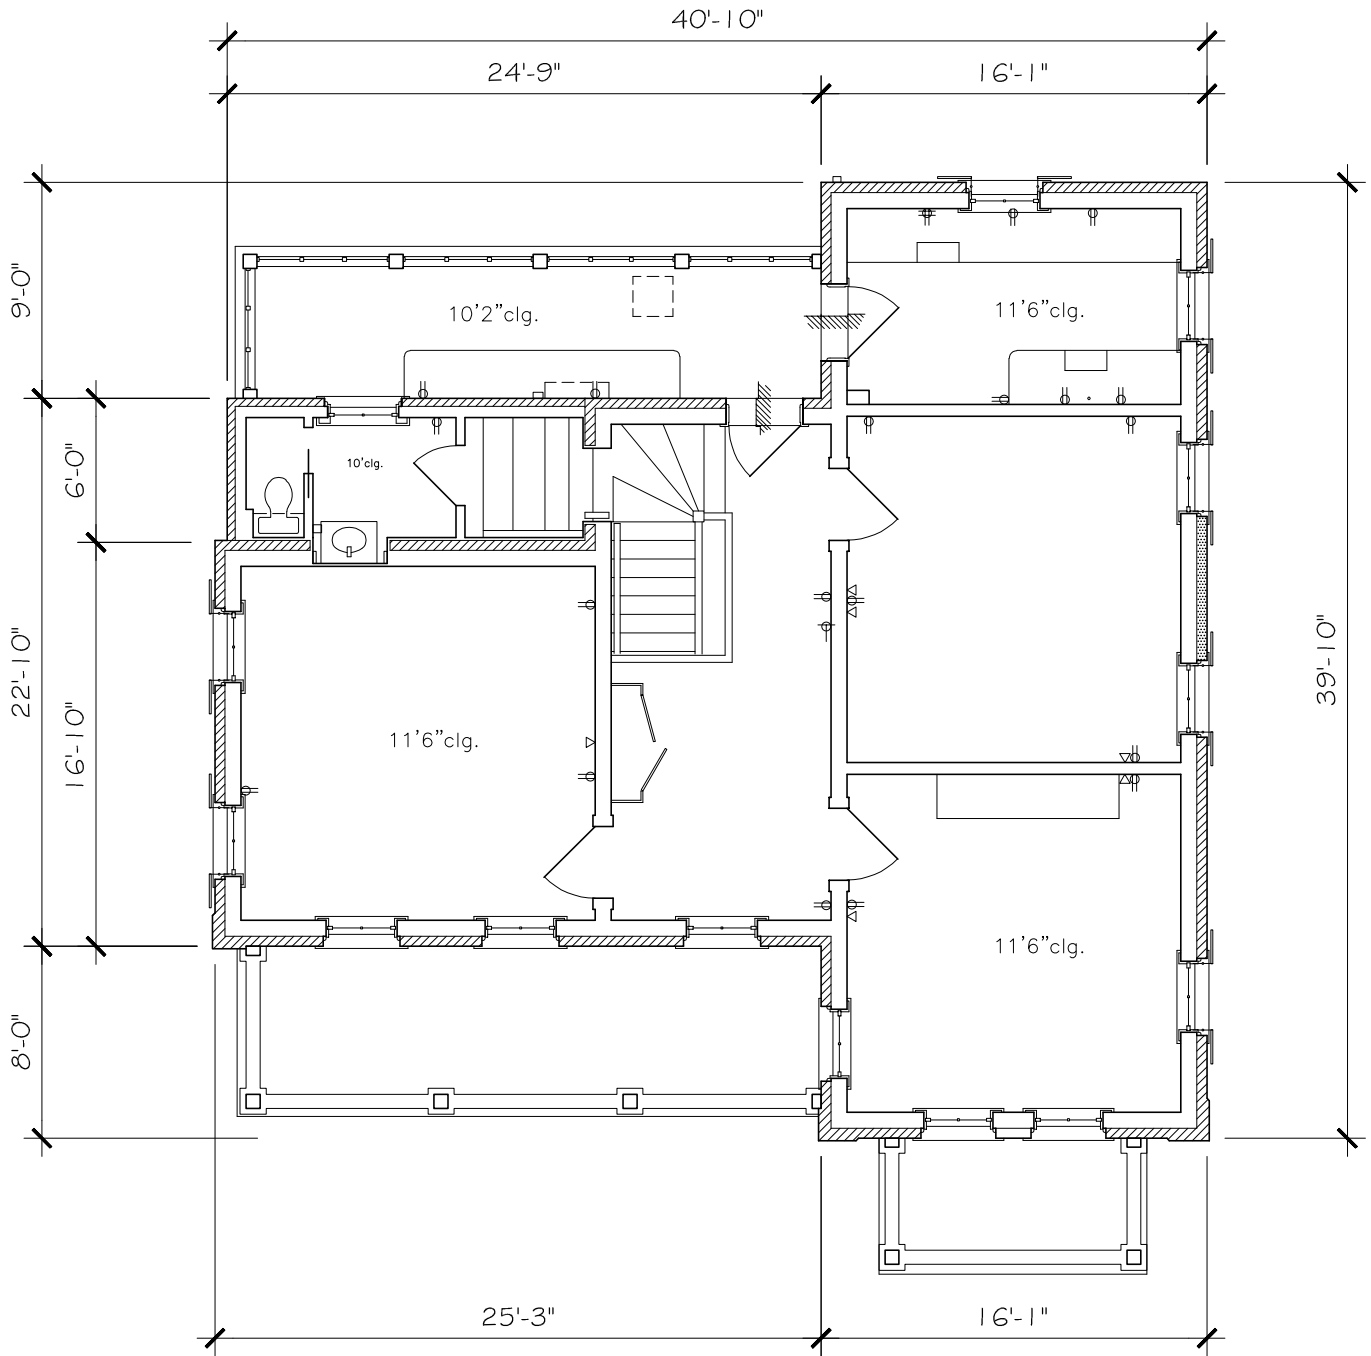

2nd FLOOR PLAN


A/C AREA
front porches

1,359 SF
236 SF

1/8" = 1'-0"

AS-BUILT DRAWINGS

635 S. PRESA
San Antonio, TX. 78210

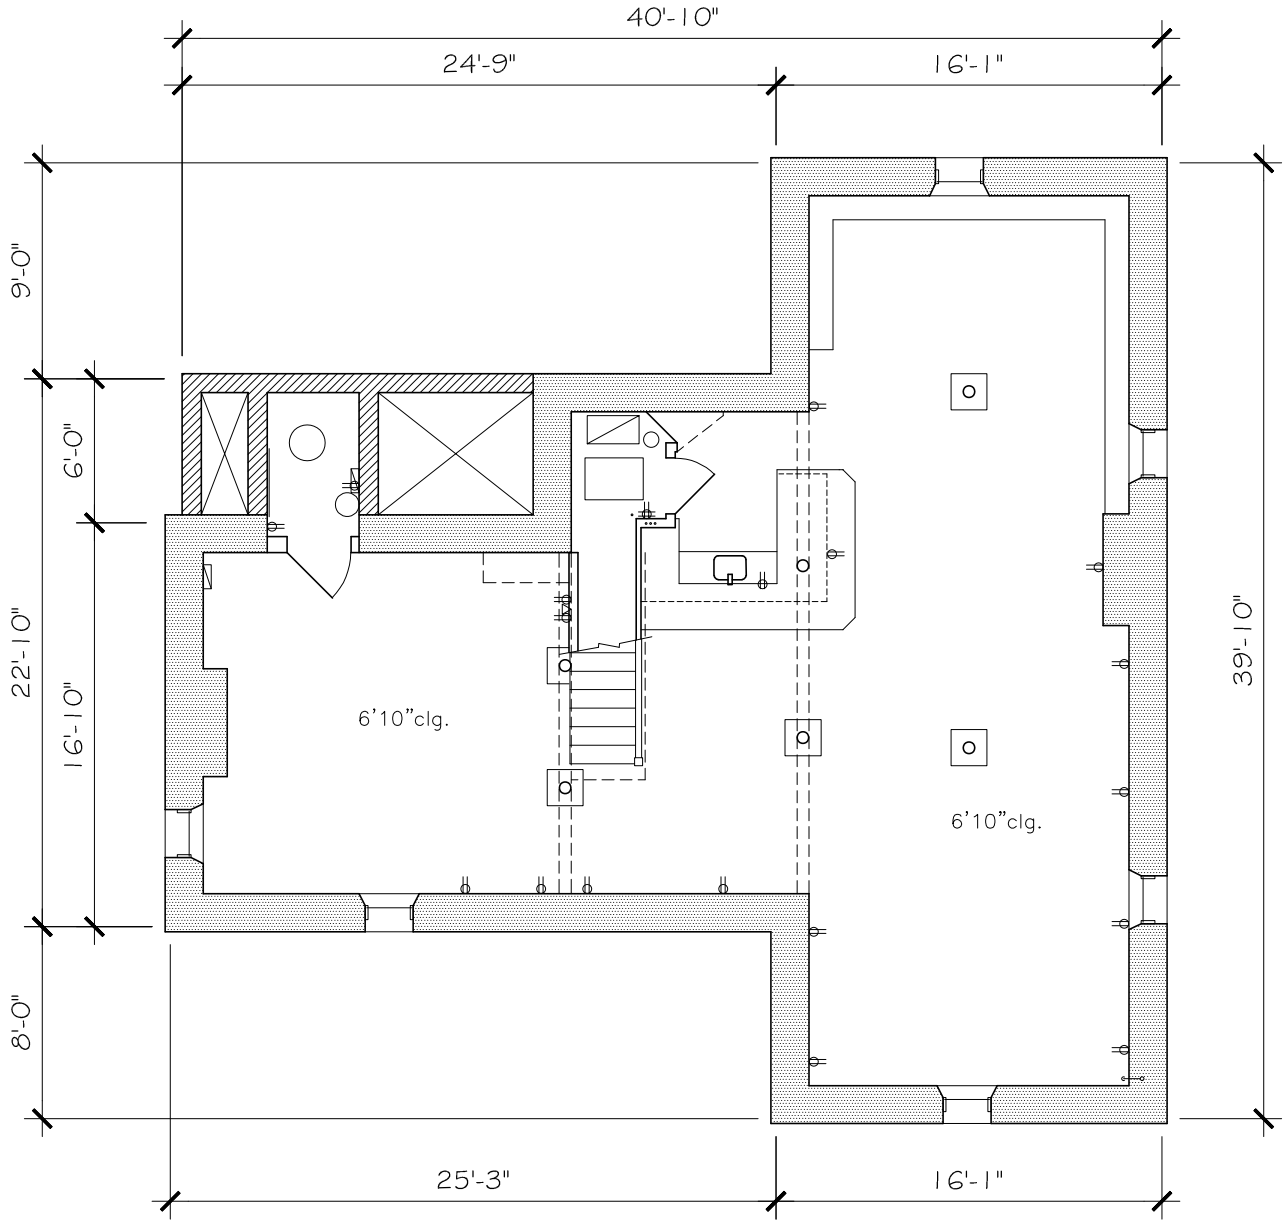


BASEMENT AREA

A/C AREA 1,159 sq.ft. 1/8" = 1'-0"

AS-BUILT DRAWINGS

635 S. PRESA
 San Antonio, TX. 78210

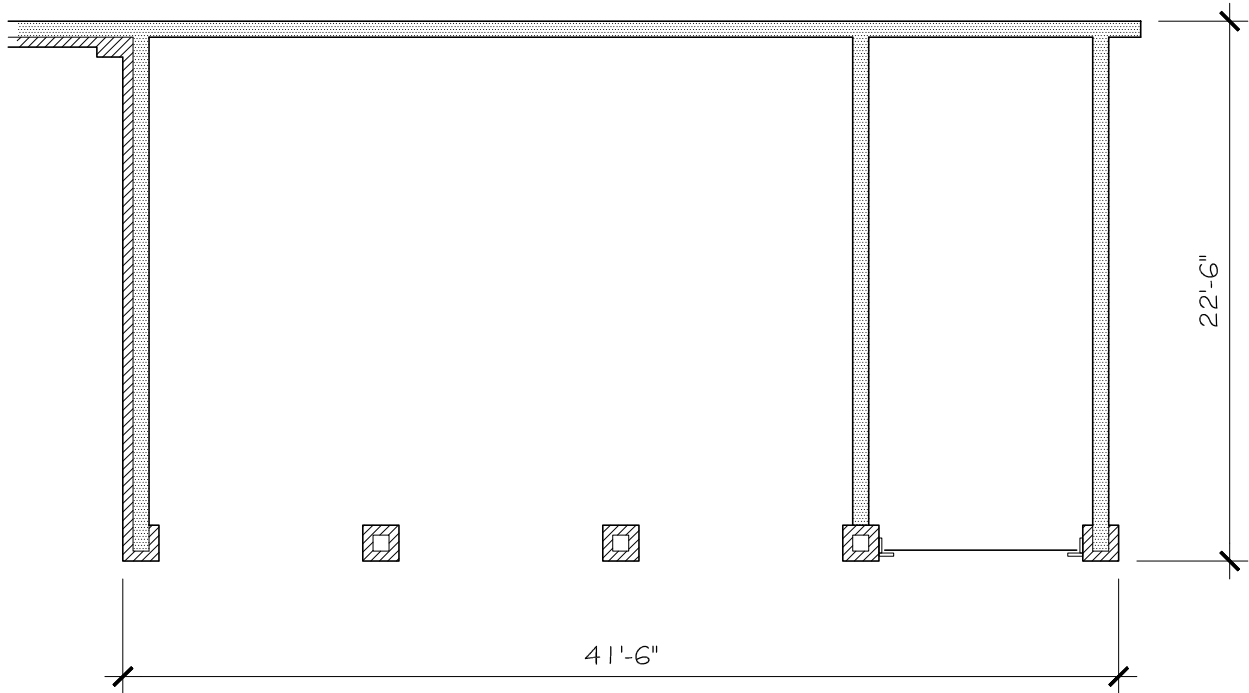

GARAGE

GARAGE 925 SF

1/8" = 1'-0"

AS-BUILT DRAWINGS

635 S. PRESA
San Antonio, TX. 78210