
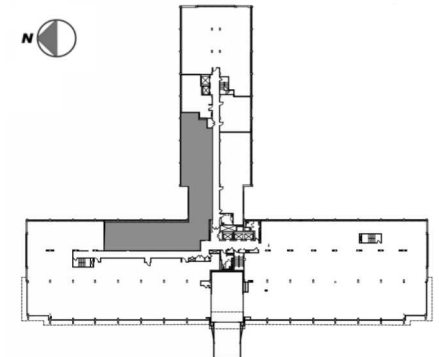


SOUTHDALE MEDICAL CENTER

6545 FRANCE AVENUE SOUTH EDINA, MN 55435

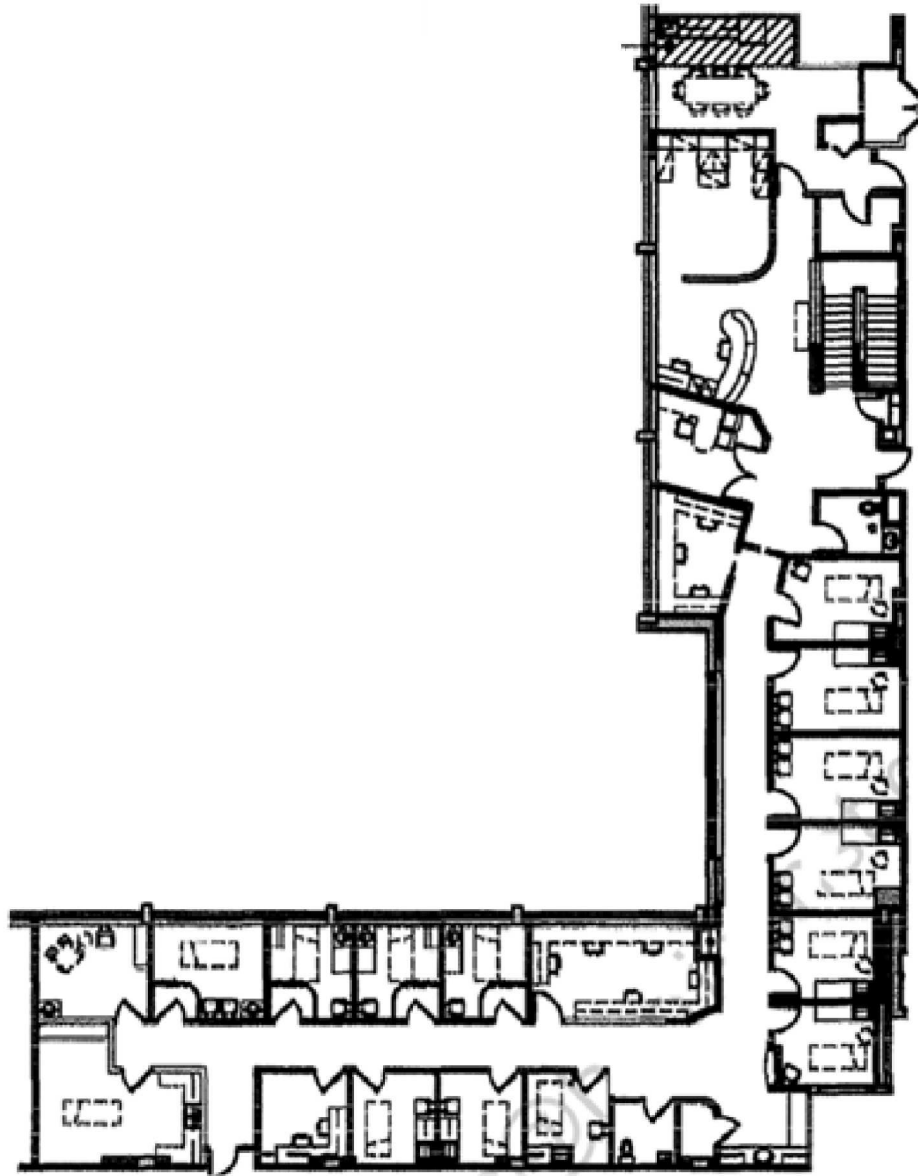


Suite: 234

5,730 Rentable Square Feet

Mike Fleetham
952-767-2842 (direct)
612-386-0993 (mobile)
mfleetham@medcraft.com

Jolene Ludvigsen
952-838-7126 (direct)
612-889-7586 (mobile)
judvigsen@medcraft.com

Leased by:
 **MedCraft**
Healthcare Real Estate

Managed by:
 **FRAUENSHUH**