


KEY PLAN

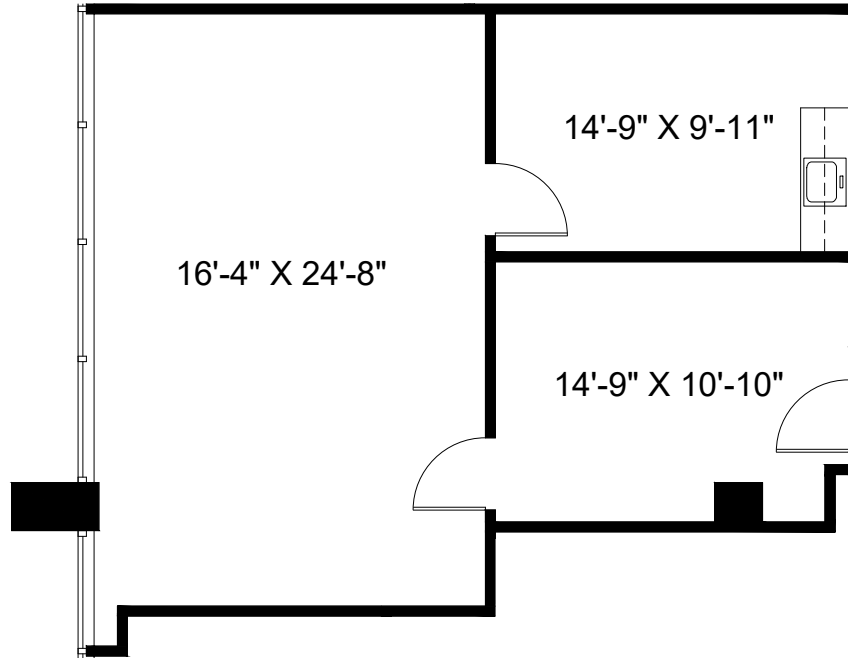

800 W. AIRPORT FREEWAY

IRVING, TEXAS 75062

AS-BUILT PLAN
SUITE 745

rsf: 853

scale: 1/8" = 1'-0"

date: 03.20.2024



1201 main street
suite 1370
dallas, texas 75202
214.420.4646

