





ARCHITECTURE + INTERIOR DESIGN


5076 WINTERS CHAPEL RD, SUITE 100
ATLANTA, GA 30380
(404) 770.398.3207


Deerfield Commons I

12600 Deerfield Pky
Alpharetta, Georgia 30004

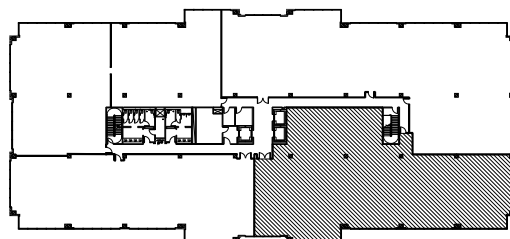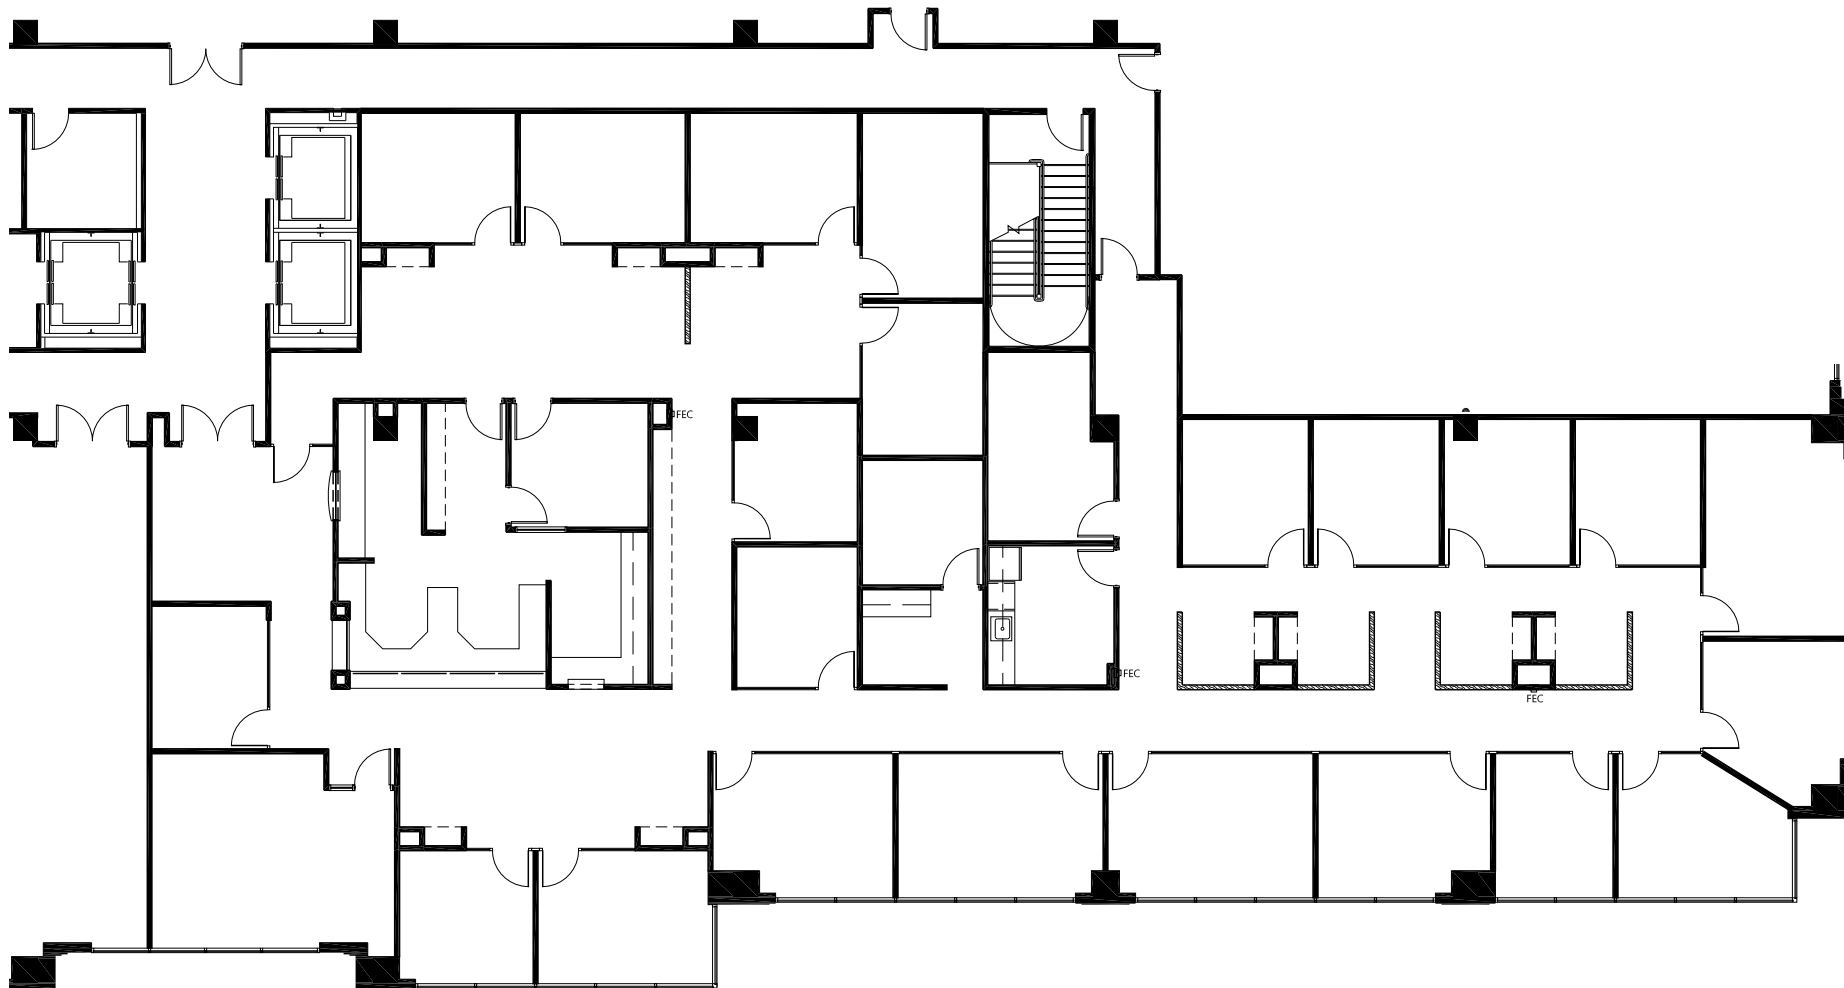

As-Built

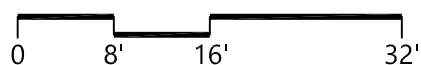

4th Floor - Suite 400 
8,402 RSF
02/04/25

 **TRANSWESTERN**[®]
The Performance Advantage in Real Estate

For leasing information, contact:

Greg Frankum
(404) 842-6565

Matt Spickard
(404) 842-6566

greg.frankum@transwestern.net matt.spickard@transwestern.net