


PROJECT:

1704 NW 6TH ST.

DRAWING NOTES:

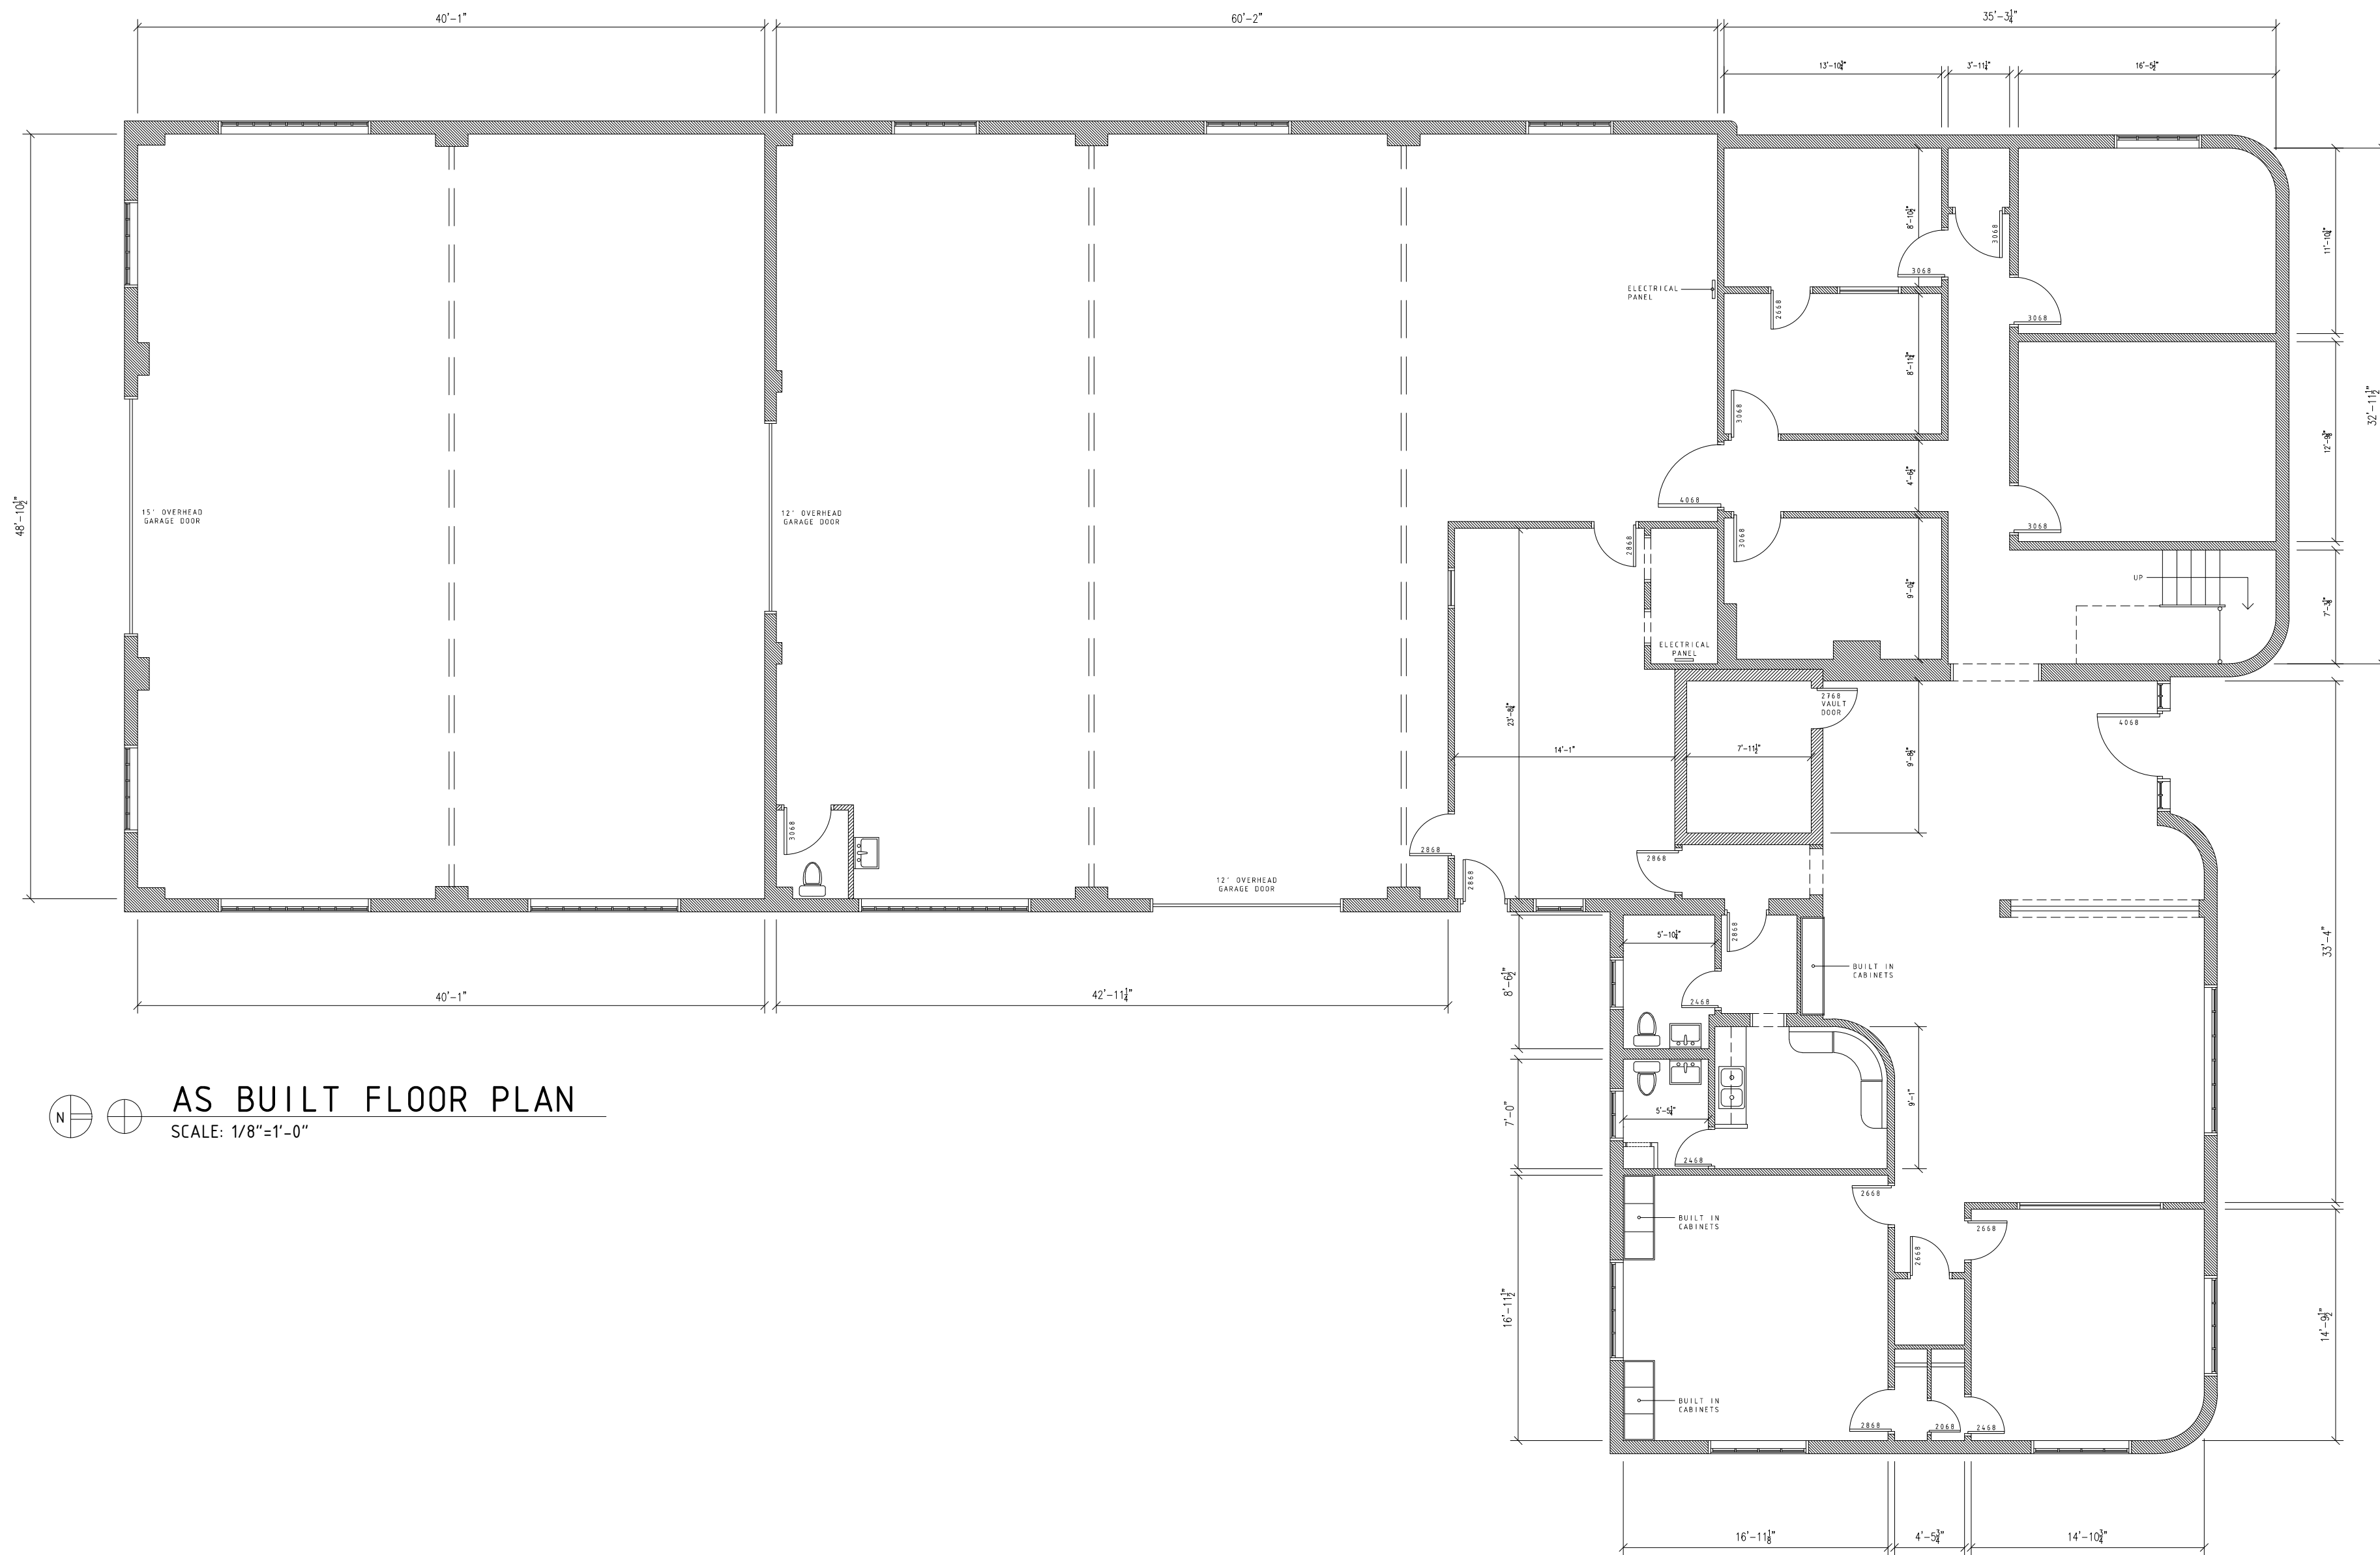

AS BUILT FLOOR PLAN  
 SCALE: 1/8"=1'-0"

DRAFT

CLIENT:

ADDRESS:  
 1704 NW 6TH ST.  
 OKLAHOMA CITY, OK  
 73106



DRAWING:  
 AS BUILT FLOOR PLAN

DRAWING NO: **A1.1**

PROJECT:

1704 NW 6TH ST.

DRAWING NOTES:

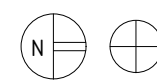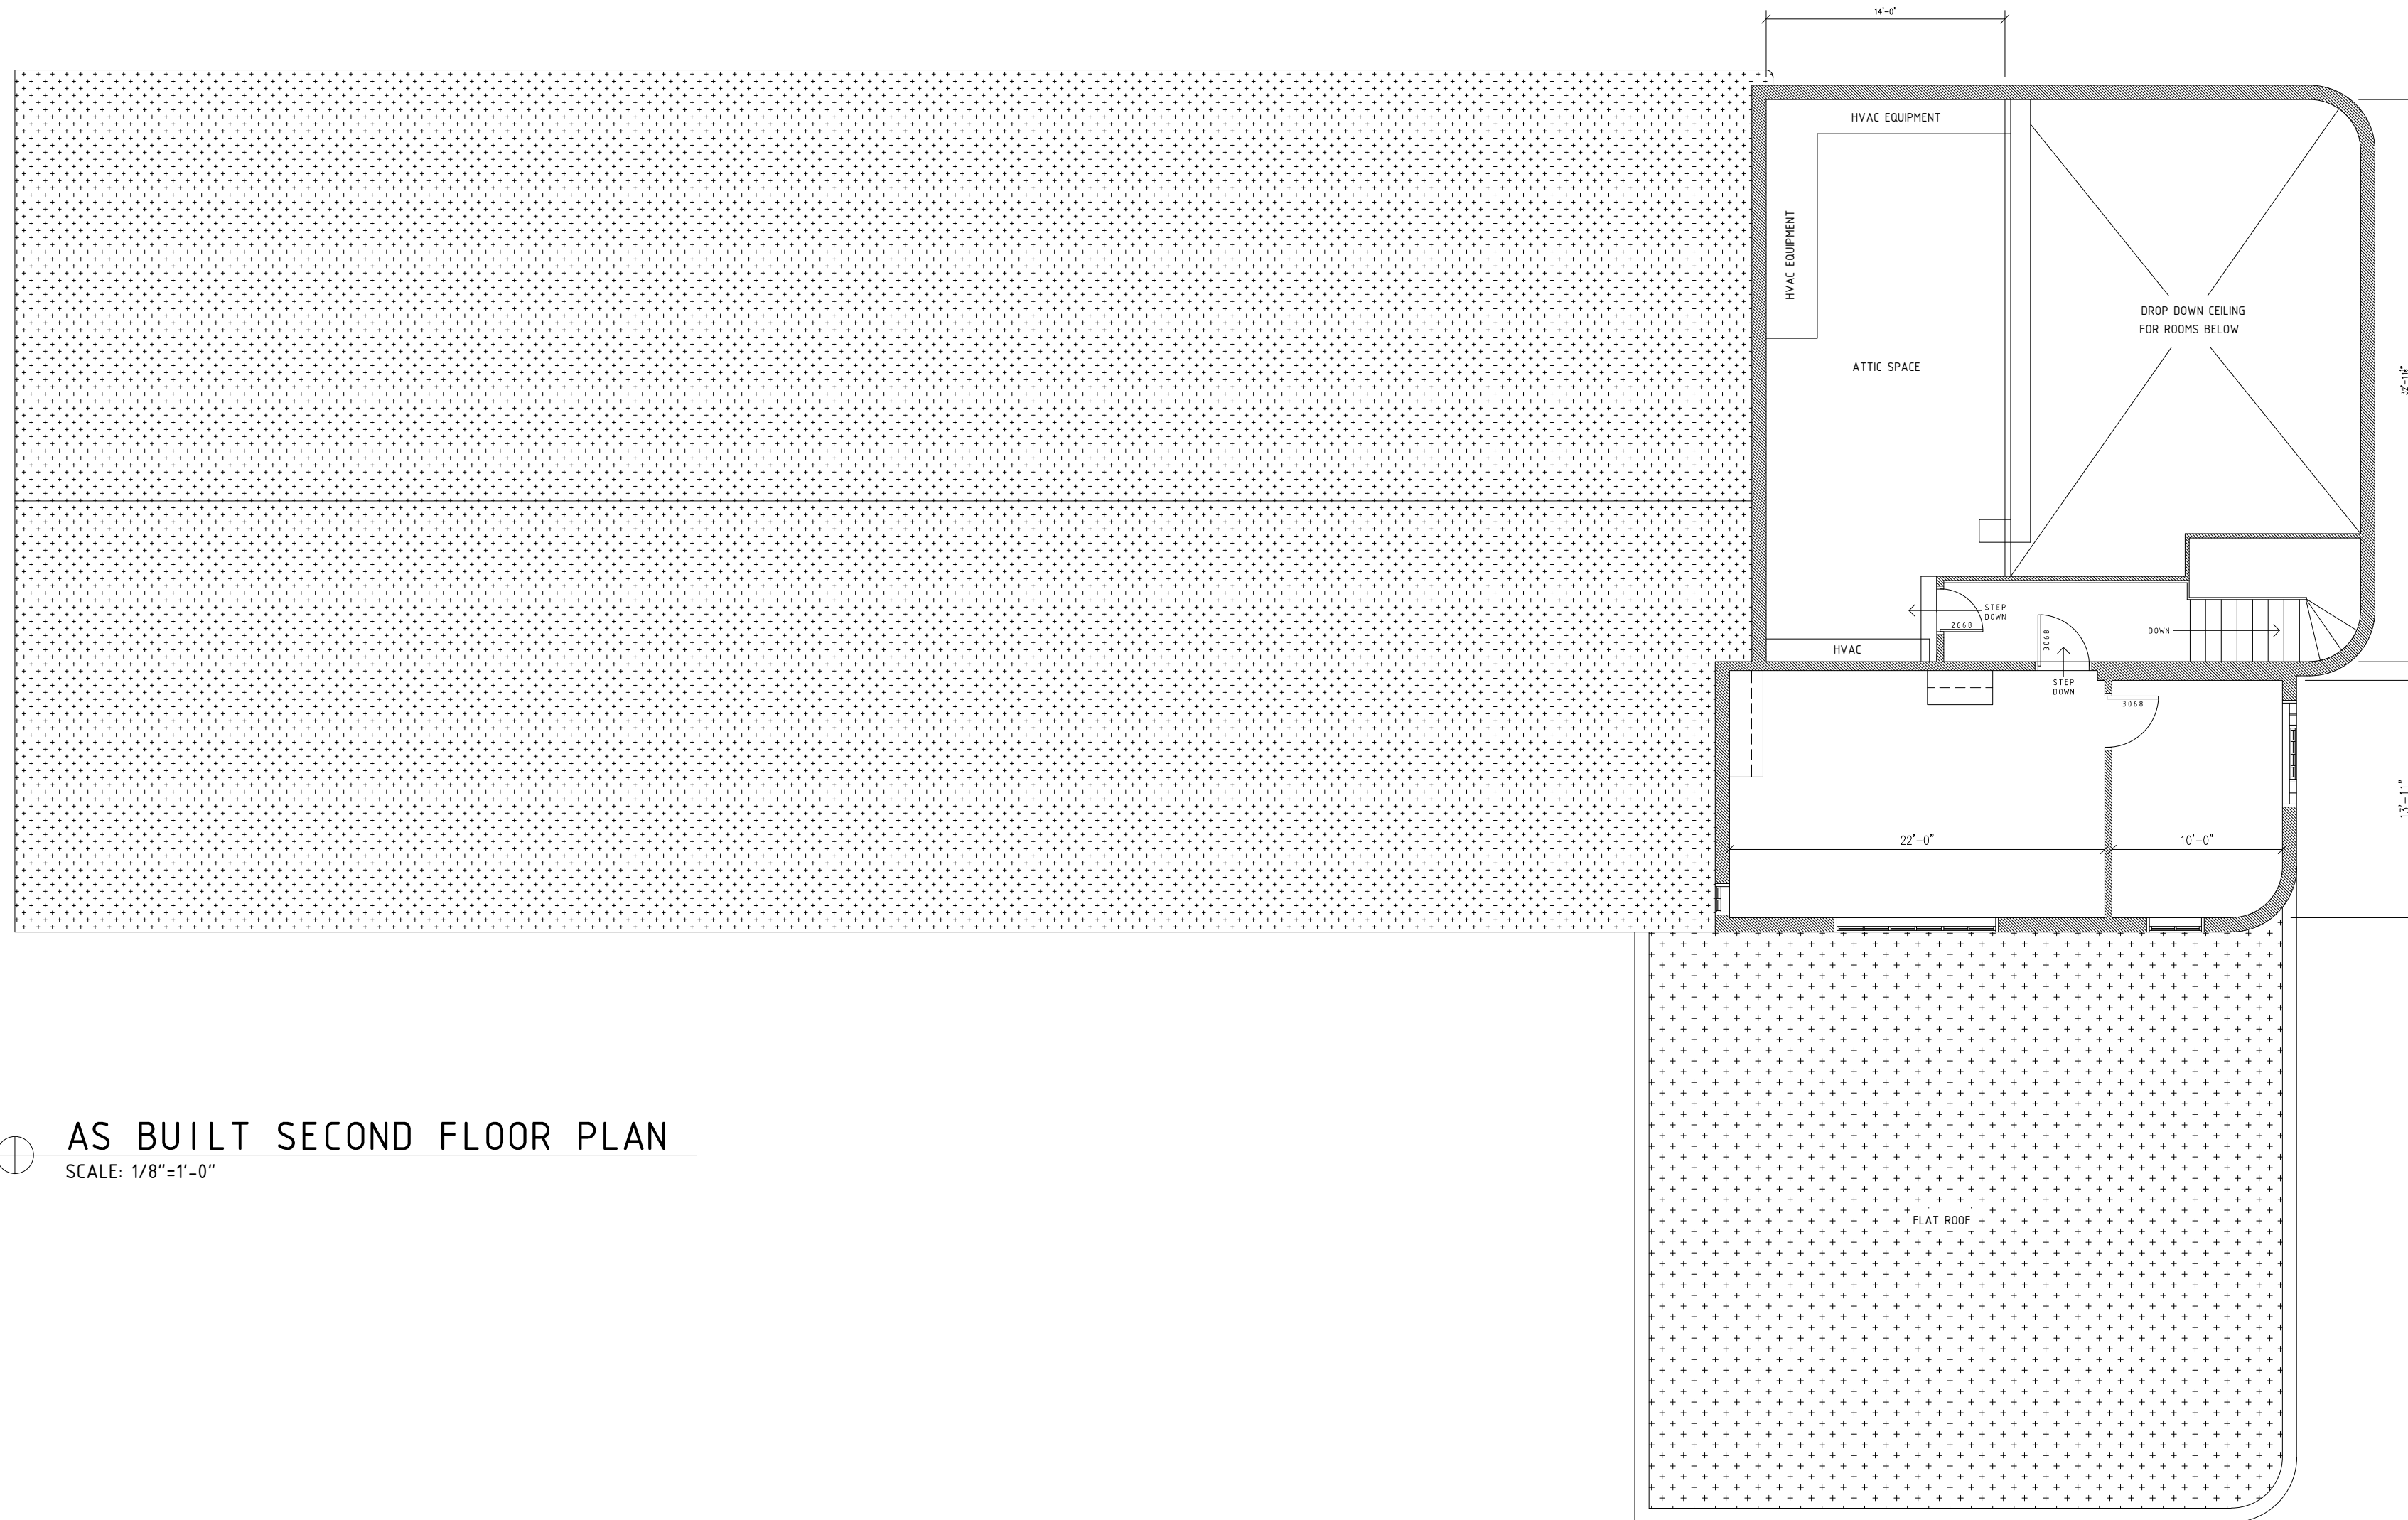

**AS BUILT SECOND FLOOR PLAN**

SCALE: 1/8"=1'-0"

DRAFT

CLIENT:

ADDRESS:

1704 NW 6TH ST.  
OKLAHOMA CITY, OK  
73106

DRAWING:

AS BUILT SECOND  
FLOOR PLAN

DRAWING NO: **A1.2**