


AS BUILT

RSF

Suite 14802

4,137

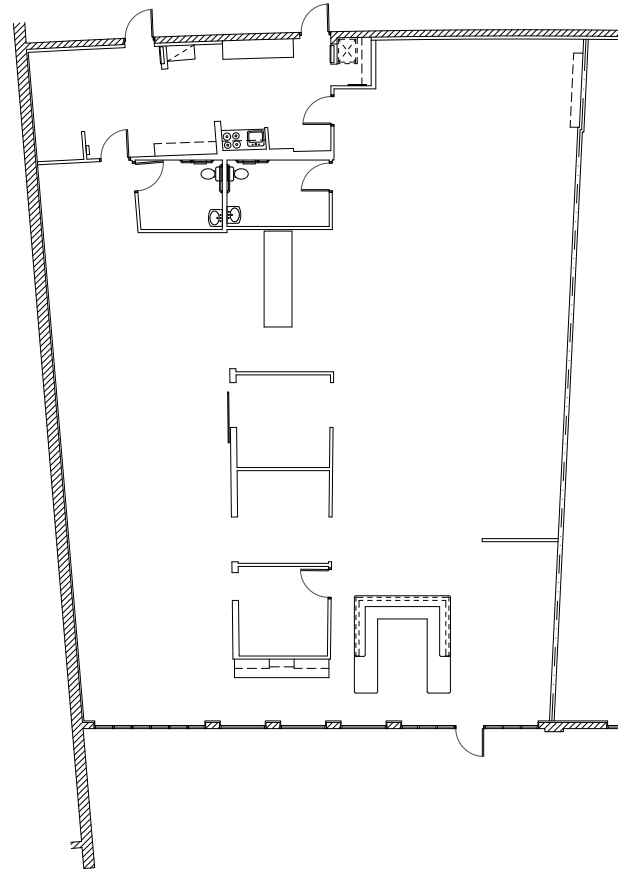

FOR LEASING INFORMATION CONTACT

Rachael Thompson
602.513.5122 | rachael.thompson@kidder.com

kidder.com