


ESTRELLA
MEDICAL
CENTER

Floor 03

Suite 385
AS-BUILT

2,096 SF
AVAILABLE

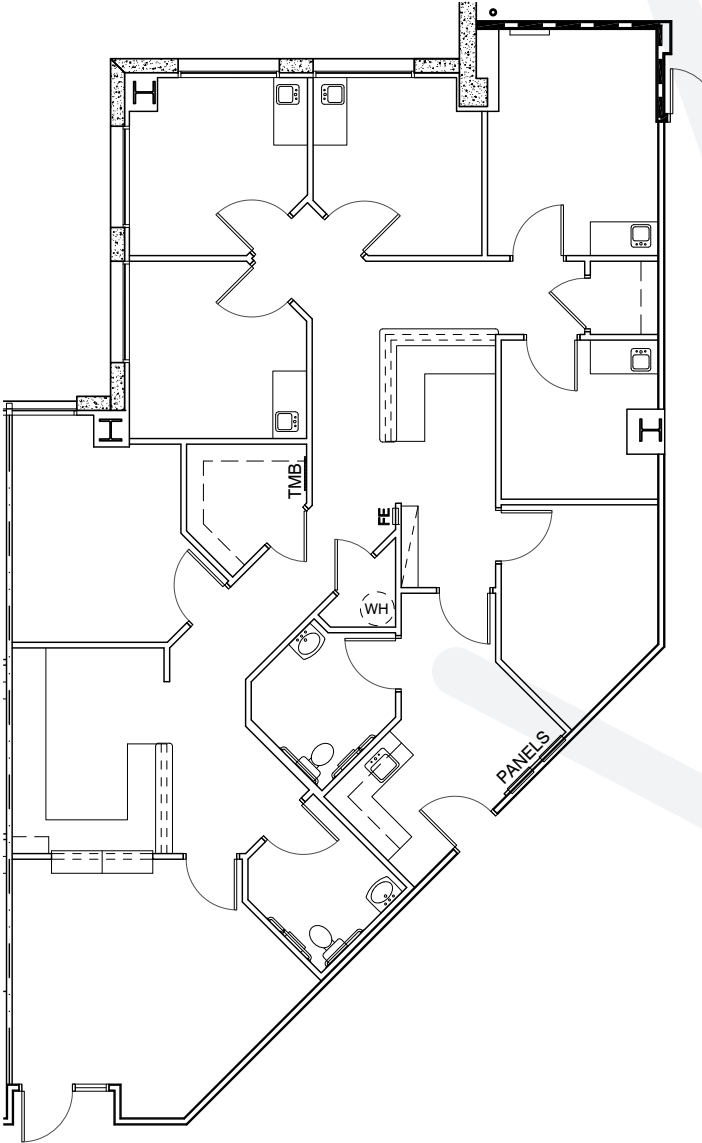

RACHAEL THOMPSON
Senior Vice President
602.513.5122
rachael.thompson@kidder.com

PERRY GABUZZI, CCIM
Senior Vice President
602.513.5116
perry.gabuzzi@kidder.com