




MEG FERGUSON
INTERIORS
155 East Main Street Suite 102
Lexington, Kentucky 40507
859.255.9400

2550 REGENCY ROAD
LEXINGTON, KENTUCKY

DATE:	06.11.26
SCALE:	N.T.S.
DRAWN BY:	KJH
REVISIONS:	

FLOOR PLAN

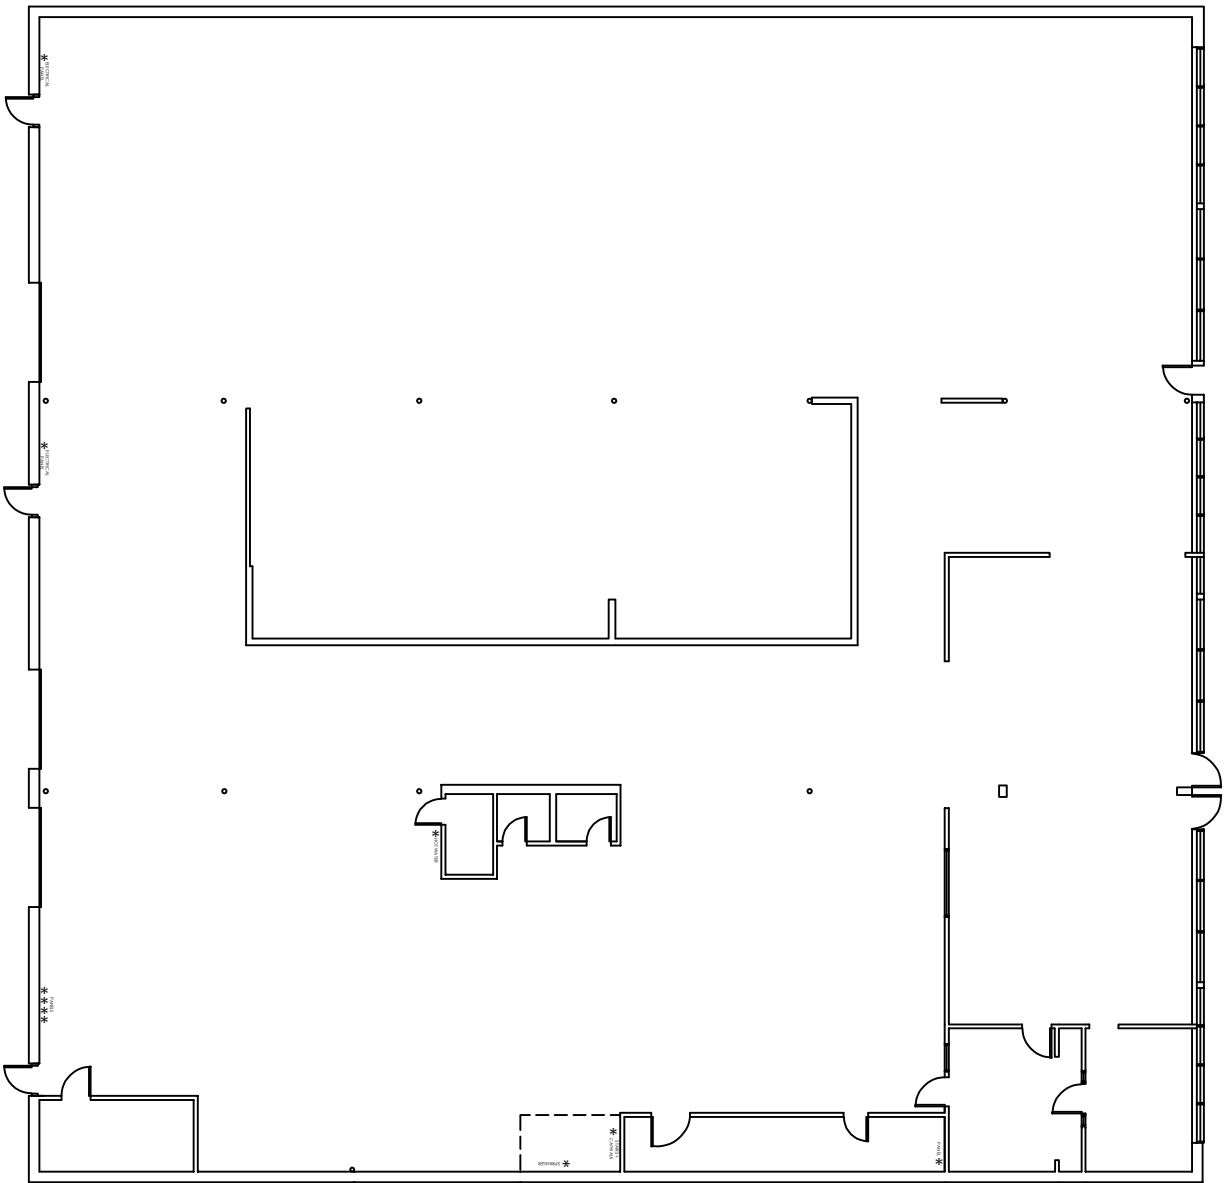

ASBUILT PLAN
SCALE: N.T.S

OVERALL ROOM DIMENSIONS ARE INTENDED TO REPRESENT GENERAL
ROOM SIZES AND NOT FRAMING DIMENSIONS. ALL EXISTING CONDITIONS
SHALL BE FIELD VERIFIED PRIOR TO CONSTRUCTION.

