
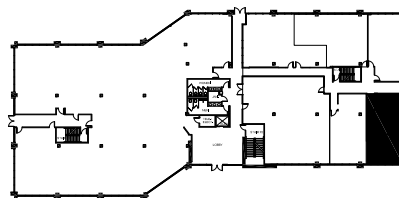


TWIN CENTRAL OFFICE BUILDING

1401 N. Central, Richardson, Texas

SUITE 118
925 RSF

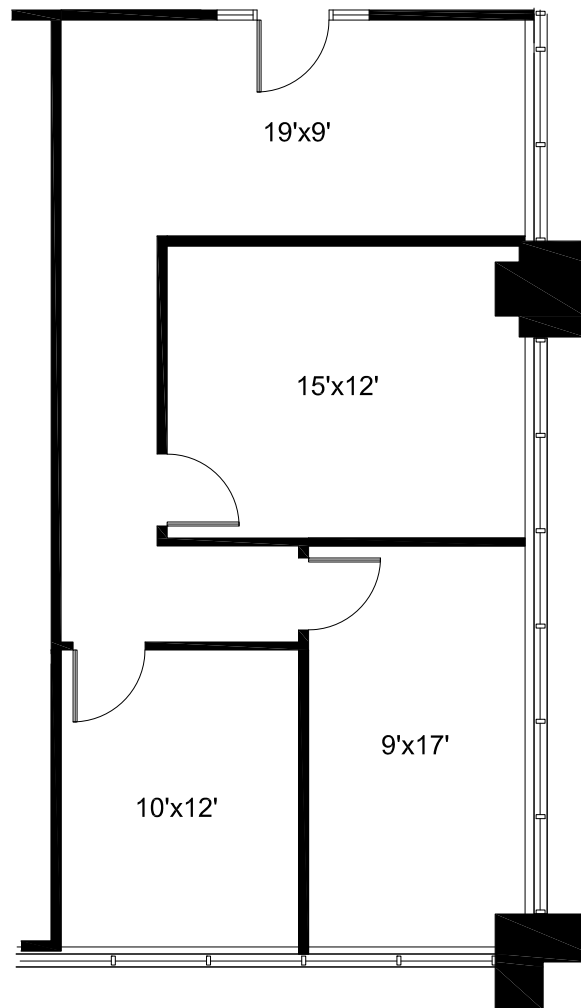

1ST FLOOR

Scale: 1/8"=1'-0"

All dimensions and square footages are approximate.

August 6, 2026



DFW DESIGN DEPOT

(817) 929-8804