



NORTHMEADOW



11390 OLD ROSWELL RD


Suite 114 | Roswell, Georgia 30076

BUILDING FEATURES

- » 47,628 SF Office/Flex Building
- » 80% Office Finish
- » Grade-Level Loading
- » 14' Ceiling Height
- » Ample Parking
- » Attractive Split-Face Block Construction
- » Fiber Optics Available

NORTHMEADOW FEATURES

- » Heavily Landscaped Park Setting
- » Ideal Corporate HQ / Medical Office
- » 19 Building Portfolio Totaling 1.2M SF on 125 Acres
- » On-site Property Management and Leasing
- » Close Proximity to GA 400 (1.5 Mile)

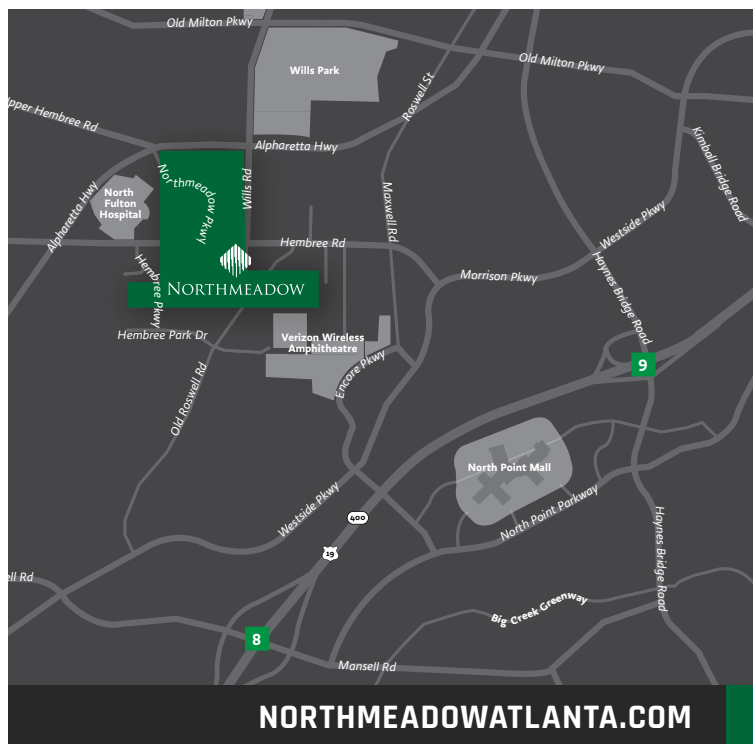

NORTHMEADOWATLANTA.COM

Information is deemed from reliable sources. No warranty is made as to its accuracy.

MIKE BERENS

404 812 4024

mberens@naibg.com

LOGAN HANER

404 812 4096

lhane@naibg.com





NORTHMEADOW

11390 OLD ROSWELL ROAD

SUITE 114 | 3,336 SF

AS BUILT PLAN

1 Grade Level Door in Warehouse

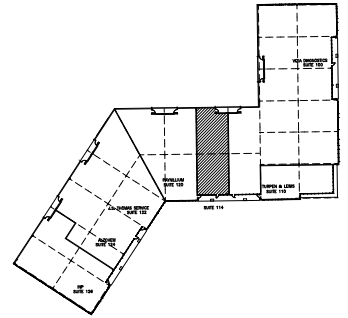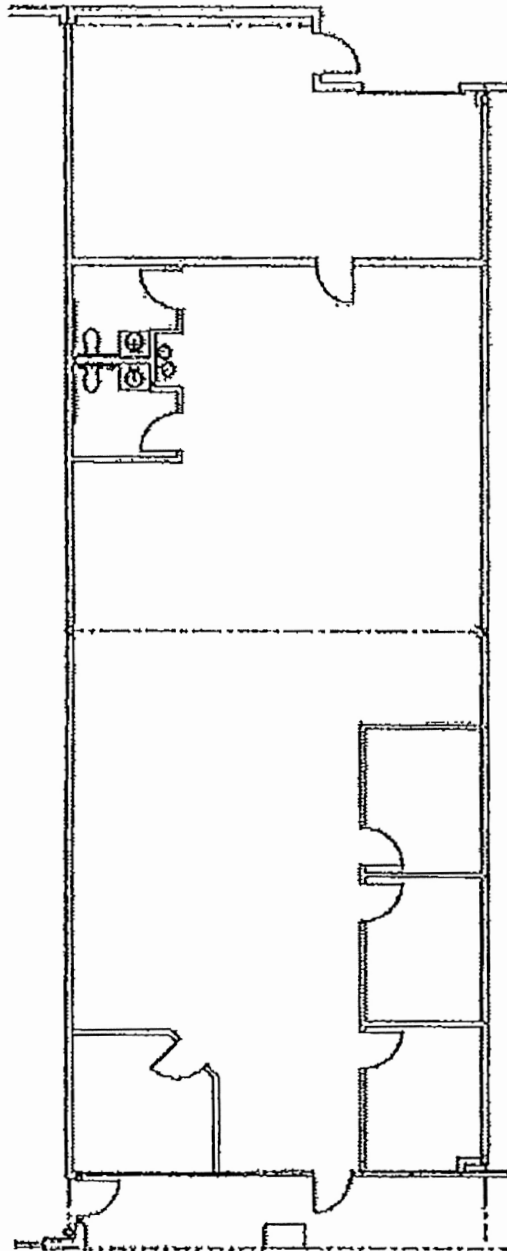

MIKE BERENS

404 812 4024

mberens@naibg.com

LOGAN HANER

404 812 4096

lhaner@naibg.com

Information is deemed from reliable sources. No warranty is made as to its accuracy.





NORTHMEADOW

11390 OLD ROSWELL ROAD

SUITE 114 | 3,336 SF

SPEC SUITE PLAN

1 Grade Level Door in Warehouse

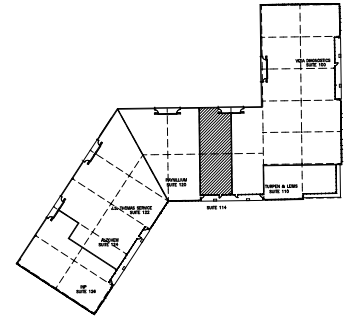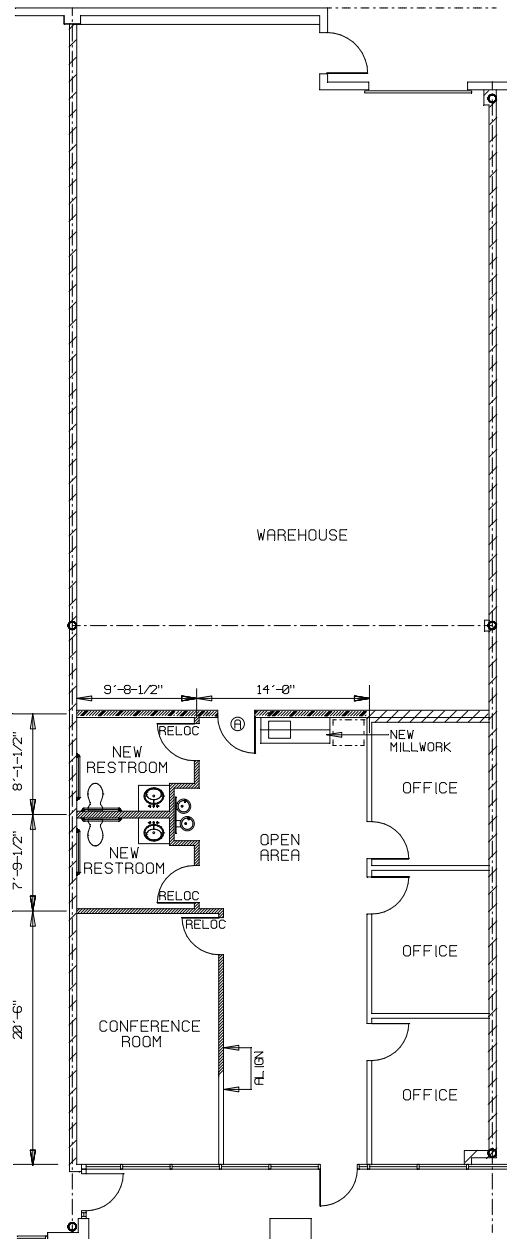

MIKE BERENS

404 812 4024

mberens@naibg.com

LOGAN HANER


404 812 4096

lhaner@naibg.com

Information is deemed from reliable sources. No warranty is made as to its accuracy.



NORTHMEADOW

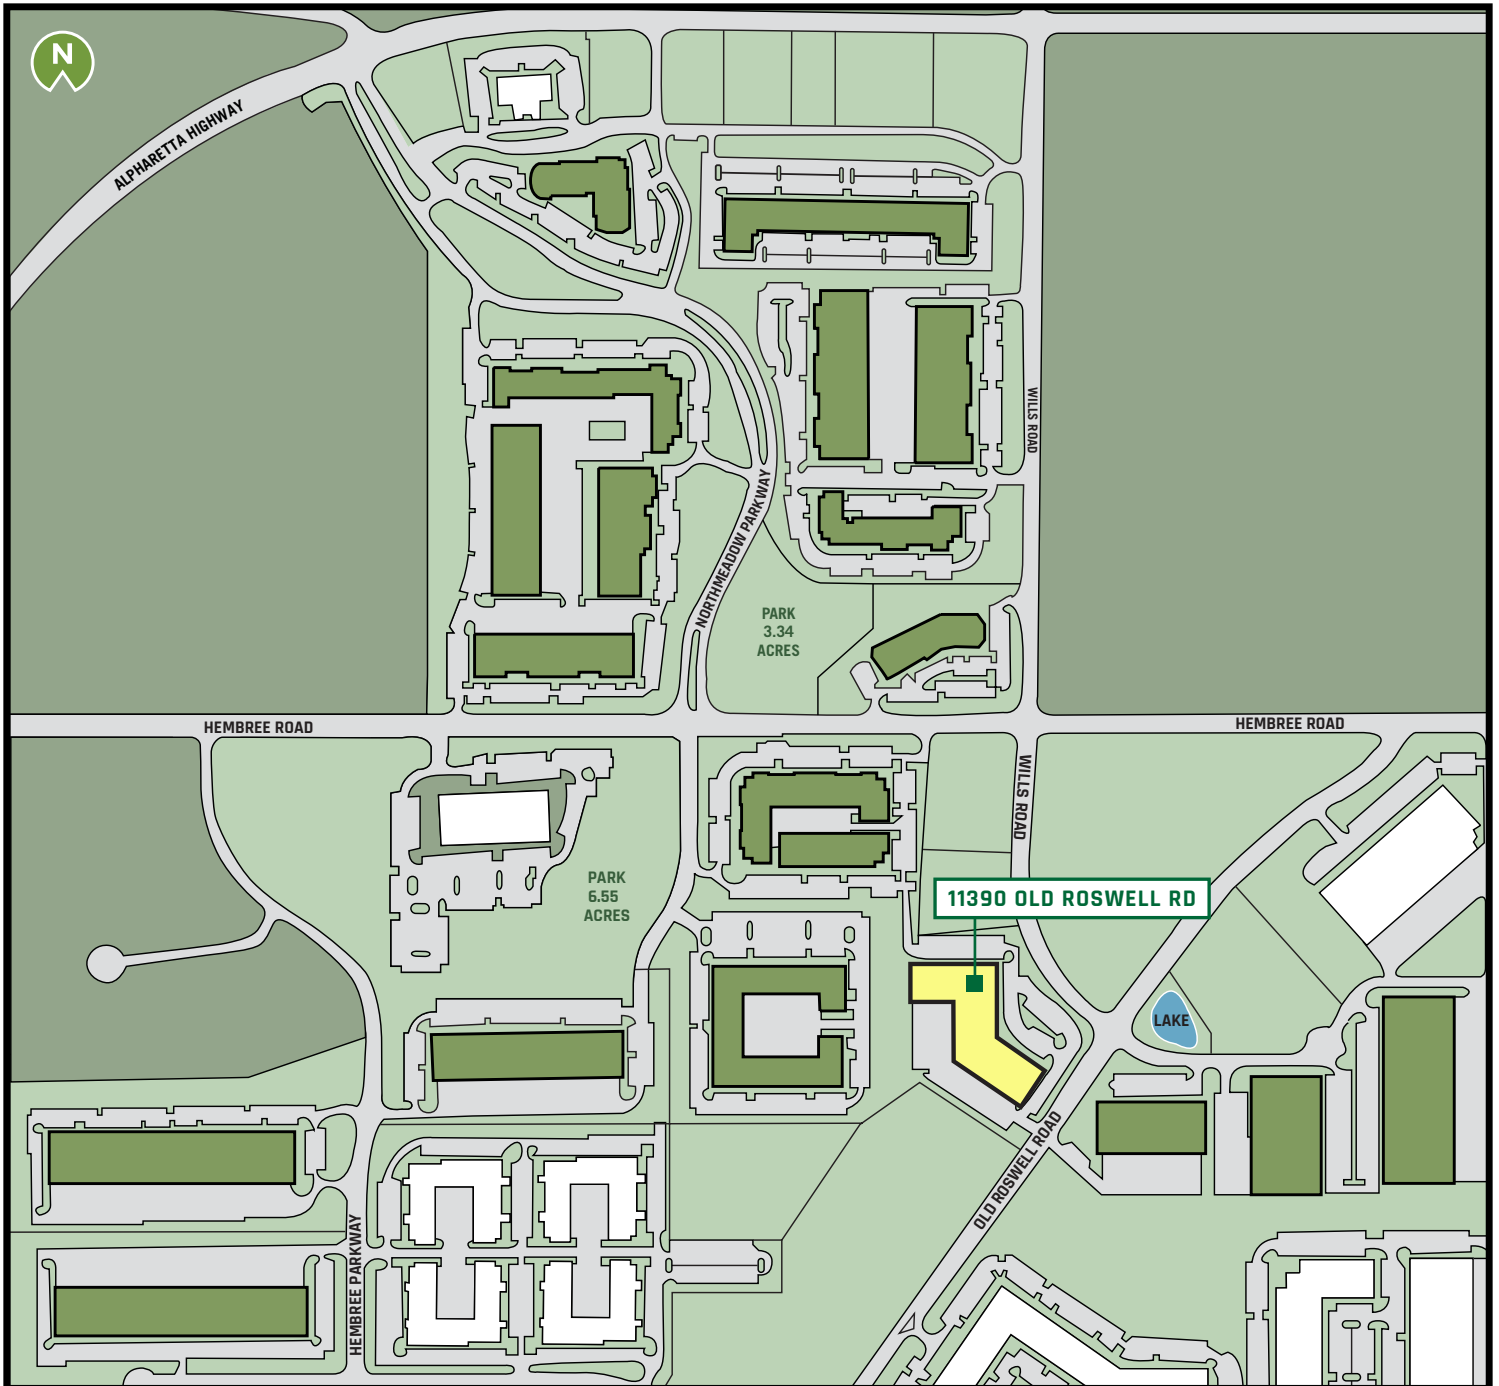

MIKE BERENS

404 812 4024

mberens@naibg.com

LOGAN HANER

404 812 4096

lhaner@naibg.com

Information is deemed from reliable sources. No warranty is made as to its accuracy.