


**BUILDING LOCATION**

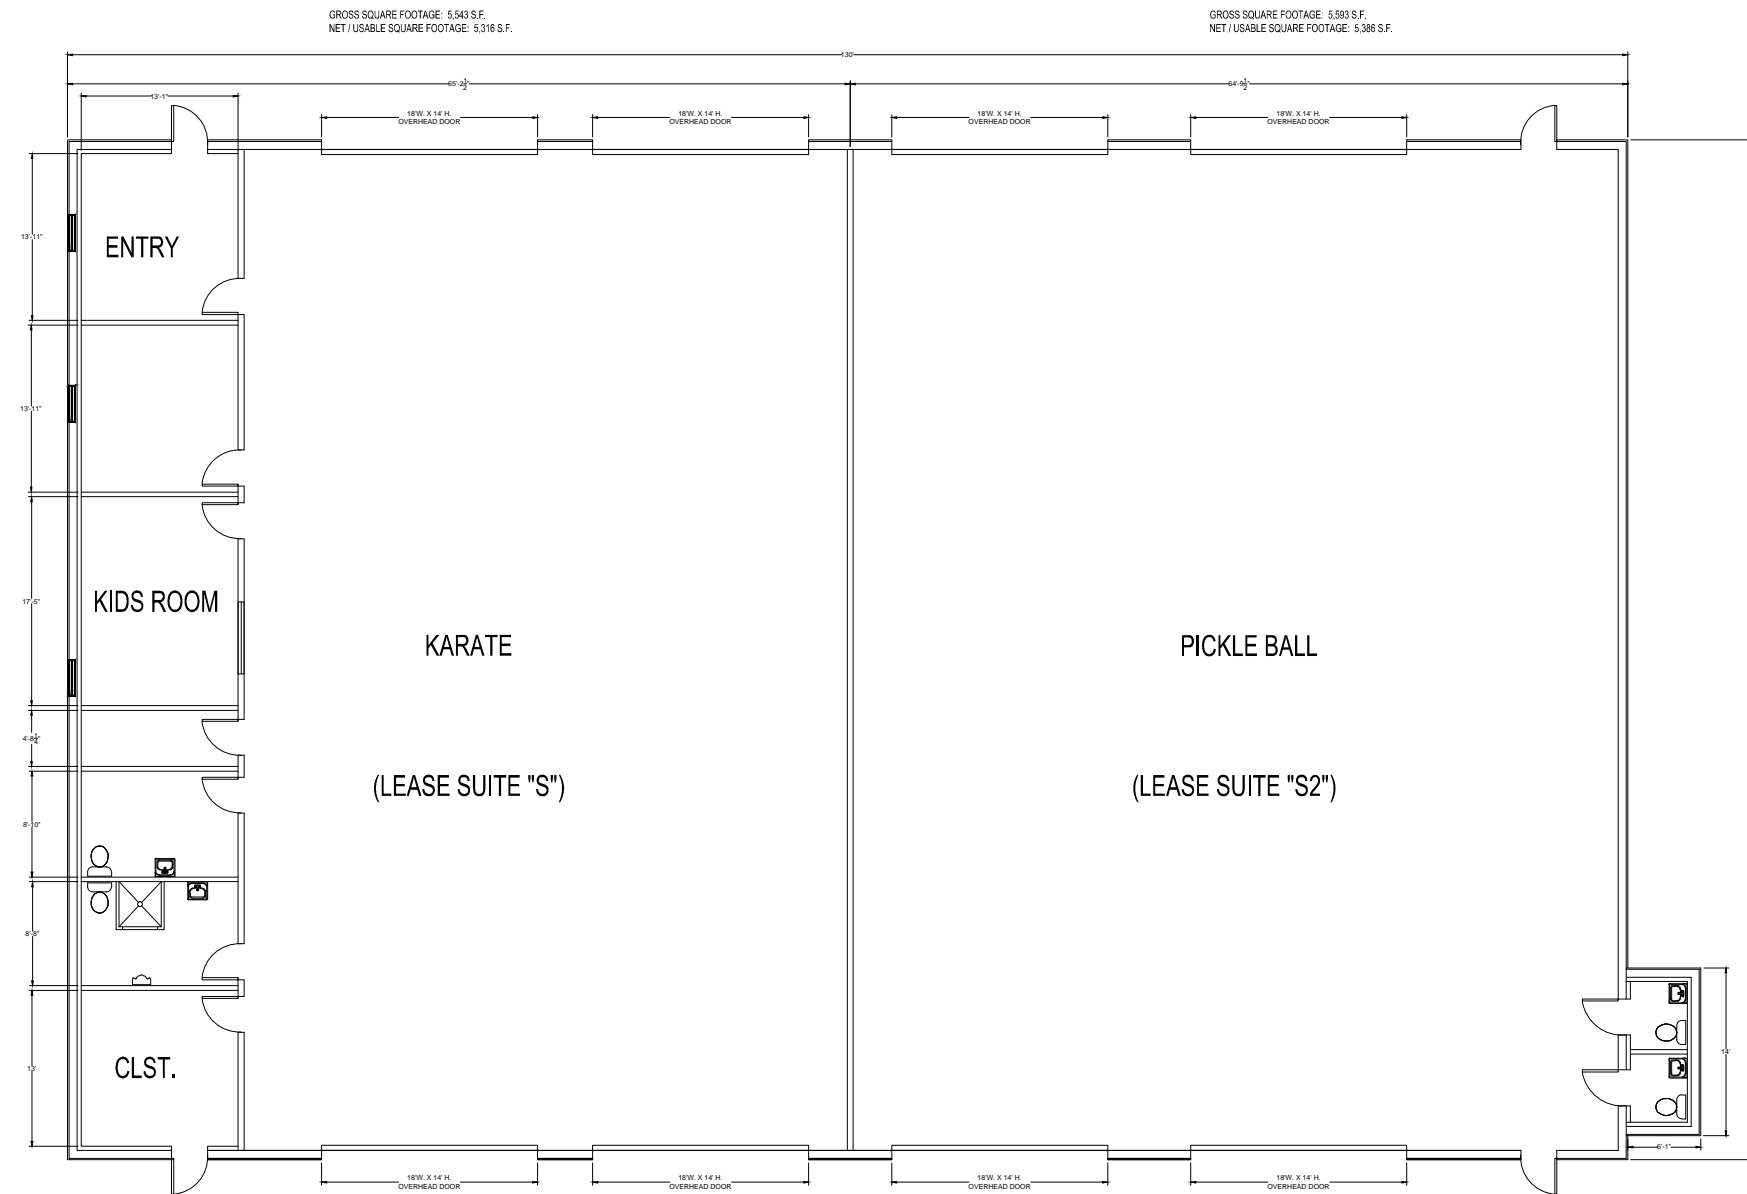

Drawings Prepared By:  
Maloney Services  
832.257.4619  
maloneyservices@yahoo.com

**PLAZA ONE**  
**AS BUILT PLANS**  
**11715 - 11719-B SPRING CYPRESS**  
**TOMBALL, TEXAS 77377**

MALONEY SERVICES L.L.C. 2025. THIS OFFICE ASSUMES NO LIABILITY FOR ERRORS OR OMISSIONS ON THESE PLANS. ALL INFORMATION MUST BE CONFIRMED PRIOR TO COMMENCEMENT OF CONSTRUCTION. IT IS THE OWNERS AND BUILDERS RESPONSIBILITY TO OBTAIN ALL NECESSARY PERMITS AND TO BE FULLY COMPLIANT WITH ALL GOVERNING CODE REQUIREMENTS FOR THE GEOGRAPHIC AREA IN WHICH THIS PROJECT IS TO BE CONSTRUCTED.

**Issue:**  
AS-BUILT DRAWINGS 10-27-2025

Date  
**10-27-2025**

Project Number  
**08242025**

Sheet Name  
**BUILDING PLAN**

Sheet Number  
**A1.10**



11,050 S.F. BUILDING  
SCALE: 1/16"=1'-0" 1