




# Archive Corporation

6914 Asphalt Avenue • Tampa, Florida 33614 • (813) 874-1577  
WWW.ARCHIVECORP.COM

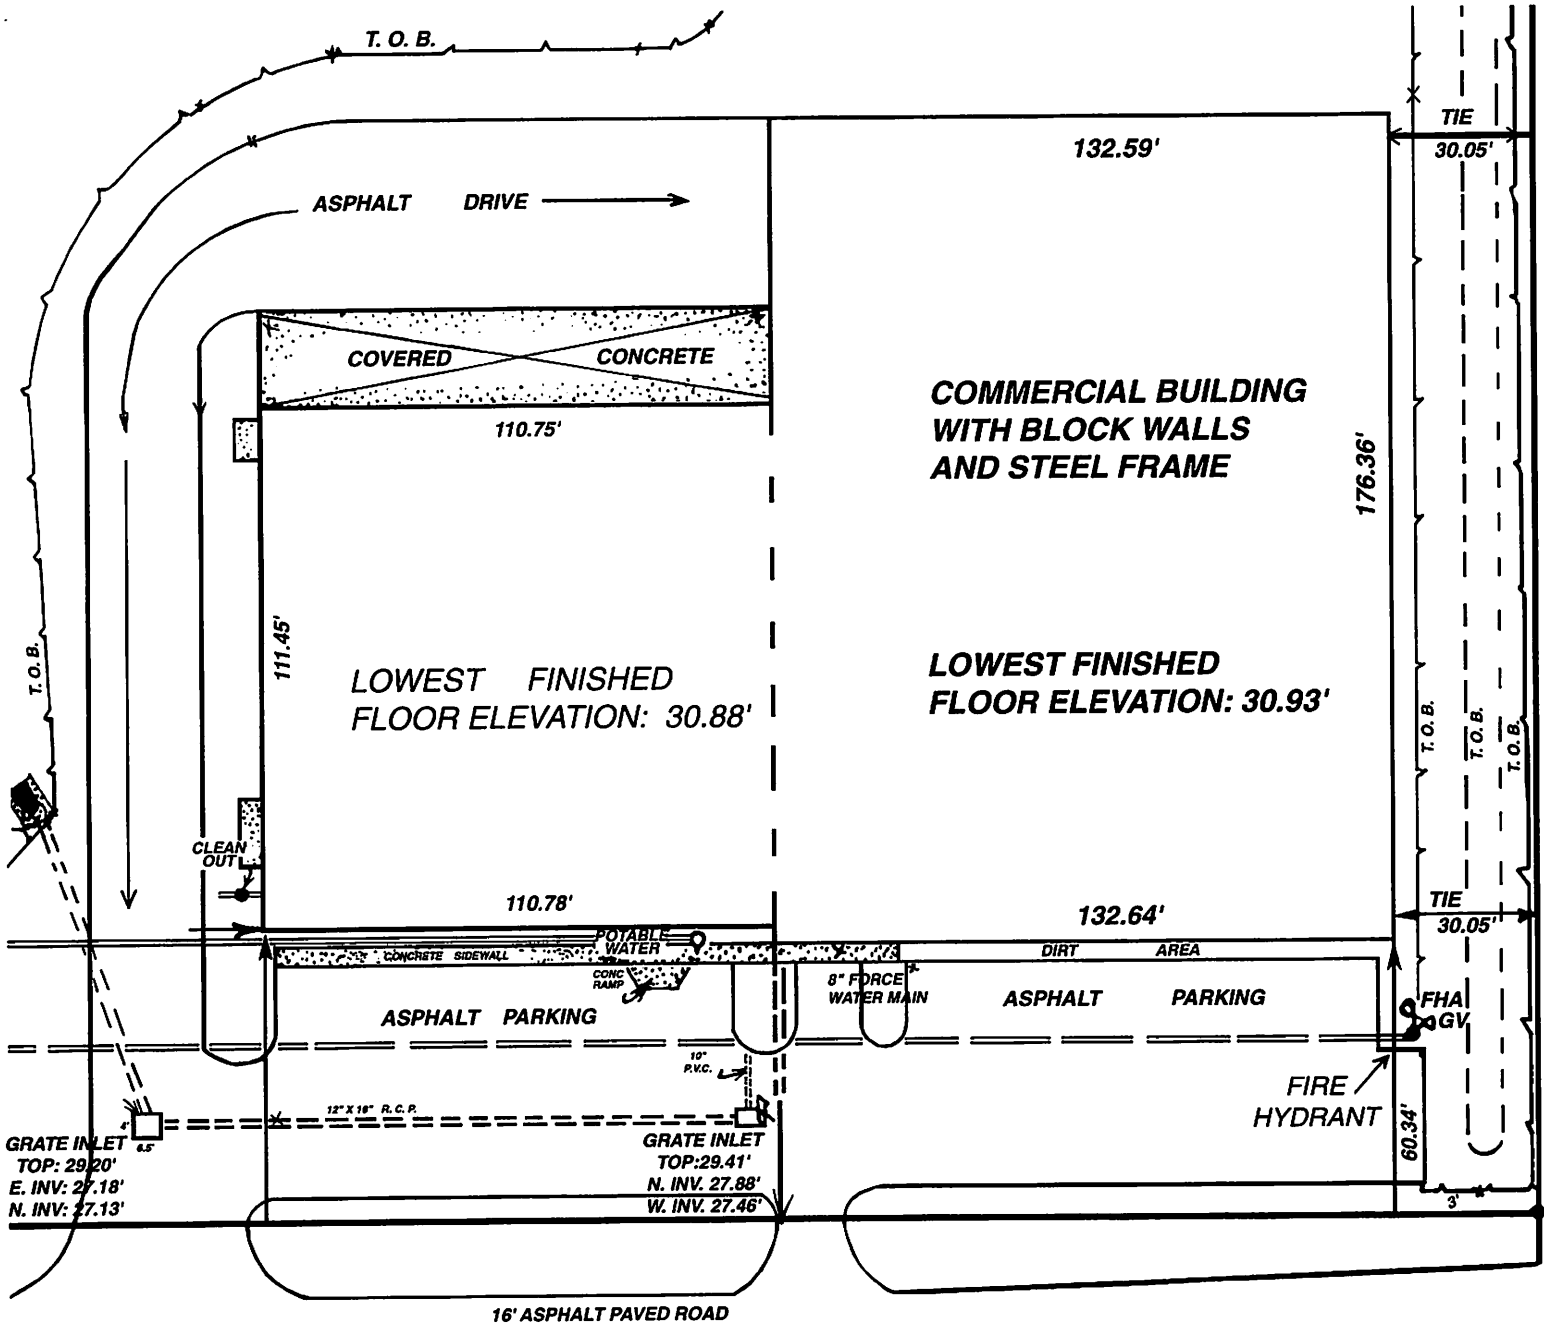

## CERTIFICATION:

I, GUY D. HALE, THE SURVEYOR IN RESPONSIBLE CHARGE, HEREBY CERTIFY THAT THE SURVEY REPRESENTED HEREON AND THAT SAID ABOVE GROUND SURVEY AND KETCH ARE ACCURATE TO THE BEST OF MY KNOWLEDGE AND BELIEF. I FURTHER CERTIFY THAT THIS SURVEY MEETS THE MINIMUM TECHNICAL STANDARDS IN SECTION 472.027, FLORIDA STATUTES (OR RULE CHAPTER 61G17-6..., F.A.C.) SURVEY NOT VALID UNLESS SEALED WITH AN EMBOSSED SEAL.

*Guy D. Hale*


WATER AND SANITARY AS BUILT: 7/12/2000  
UPDATE ON NEW SWALE: 8/30/2000  
FOUNDATION TIE IN: 5/22/2000

GUY D. HALE PLS # 4626

JOB NUMBER: 99314

09/15/99 (UPDATE)  
DATE: 08/11/99 (TOPO & JURD. LINE)  
DATE: 07/08/99 (SURVEY)  
FINAL AS-BUILT: 8/15/2000

## GUY HALE LAND SURVEYING

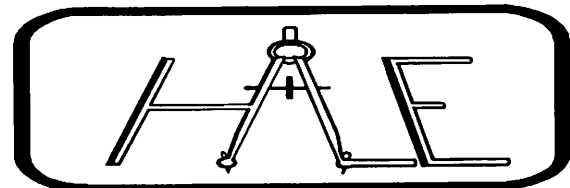

369 MEARS BOULEVARD  
OLDSMAR, FLORIDA 34677  
(813) 855-4714 • FAX (813) 855-4976