


# One Oakbrook Terrace

22nd Street & Butterfield Road  
Oakbrook Terrace, Illinois 60181

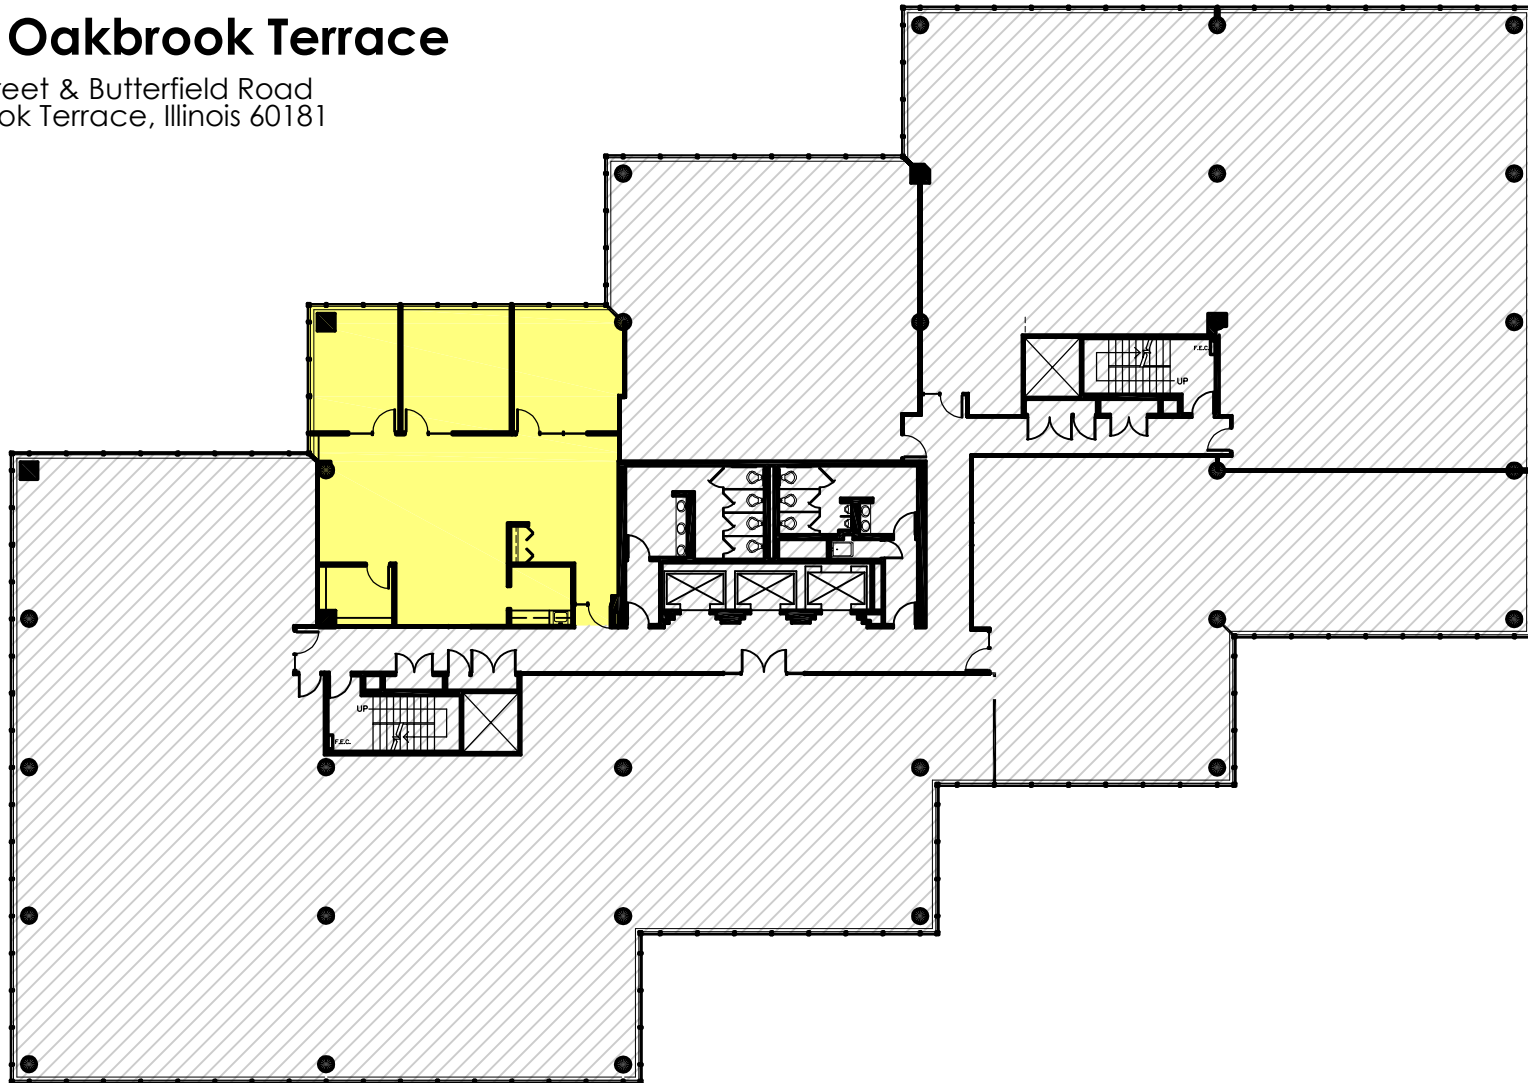

## Suite #209 - As-Built Conditions

2,076 Rentable Square Feet

Scale:

N.T.S.