

WEBB  
MEDICAL  
PLAZA B

14418 W MEEKER BLVD | SUN CITY WEST, AZ 85375


# Floor 02

## Suite 205

AS-BUILT

## 3,150 SF

AVAILABLE

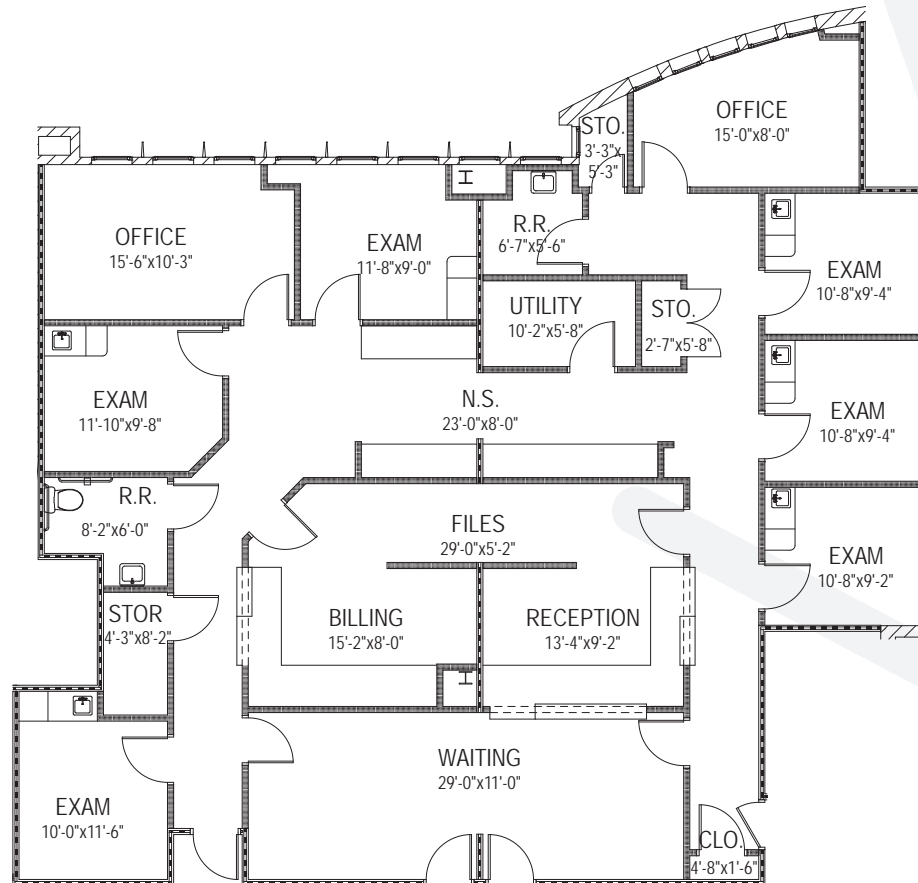

**RACHAEL THOMPSON**  
Senior Vice President  
602.513.5122  
rachael.thompson@kidder.com

**PERRY GABUZZI, CCIM**  
Senior Vice President  
602.513.5116  
perry.gabuzzi@kidder.com