


DESIGNER:  
**TIRADO DESIGN ASSOCIATES, INC.**  
 7562 CHAMINADE AVENUE  
 WEST HILLS, CA 91304


PROJECT:  
**WAREHOUSE AS-BUILT PLAN**  
 12432 FOOTHILL BLVD  
 SYLMAR, CA 91342

THE DRAWINGS AND SPECIFICATIONS ARE THE PROPERTY AND COPYRIGHT OF THE DESIGNER AND SHALL NOT BE USED ON ANY OTHER WORK EXCEPT BY WRITTEN AGREEMENT WITH THE DESIGNER. WRITTEN DIMENSIONS SHALL BE VERIFIED ON THE JOB SITE. DISCREPANCIES SHALL BE BROUGHT TO THE ATTENTION OF THE DESIGNER PRIOR TO THE COMMENCEMENT OF ANY WORK.

**NOTES**

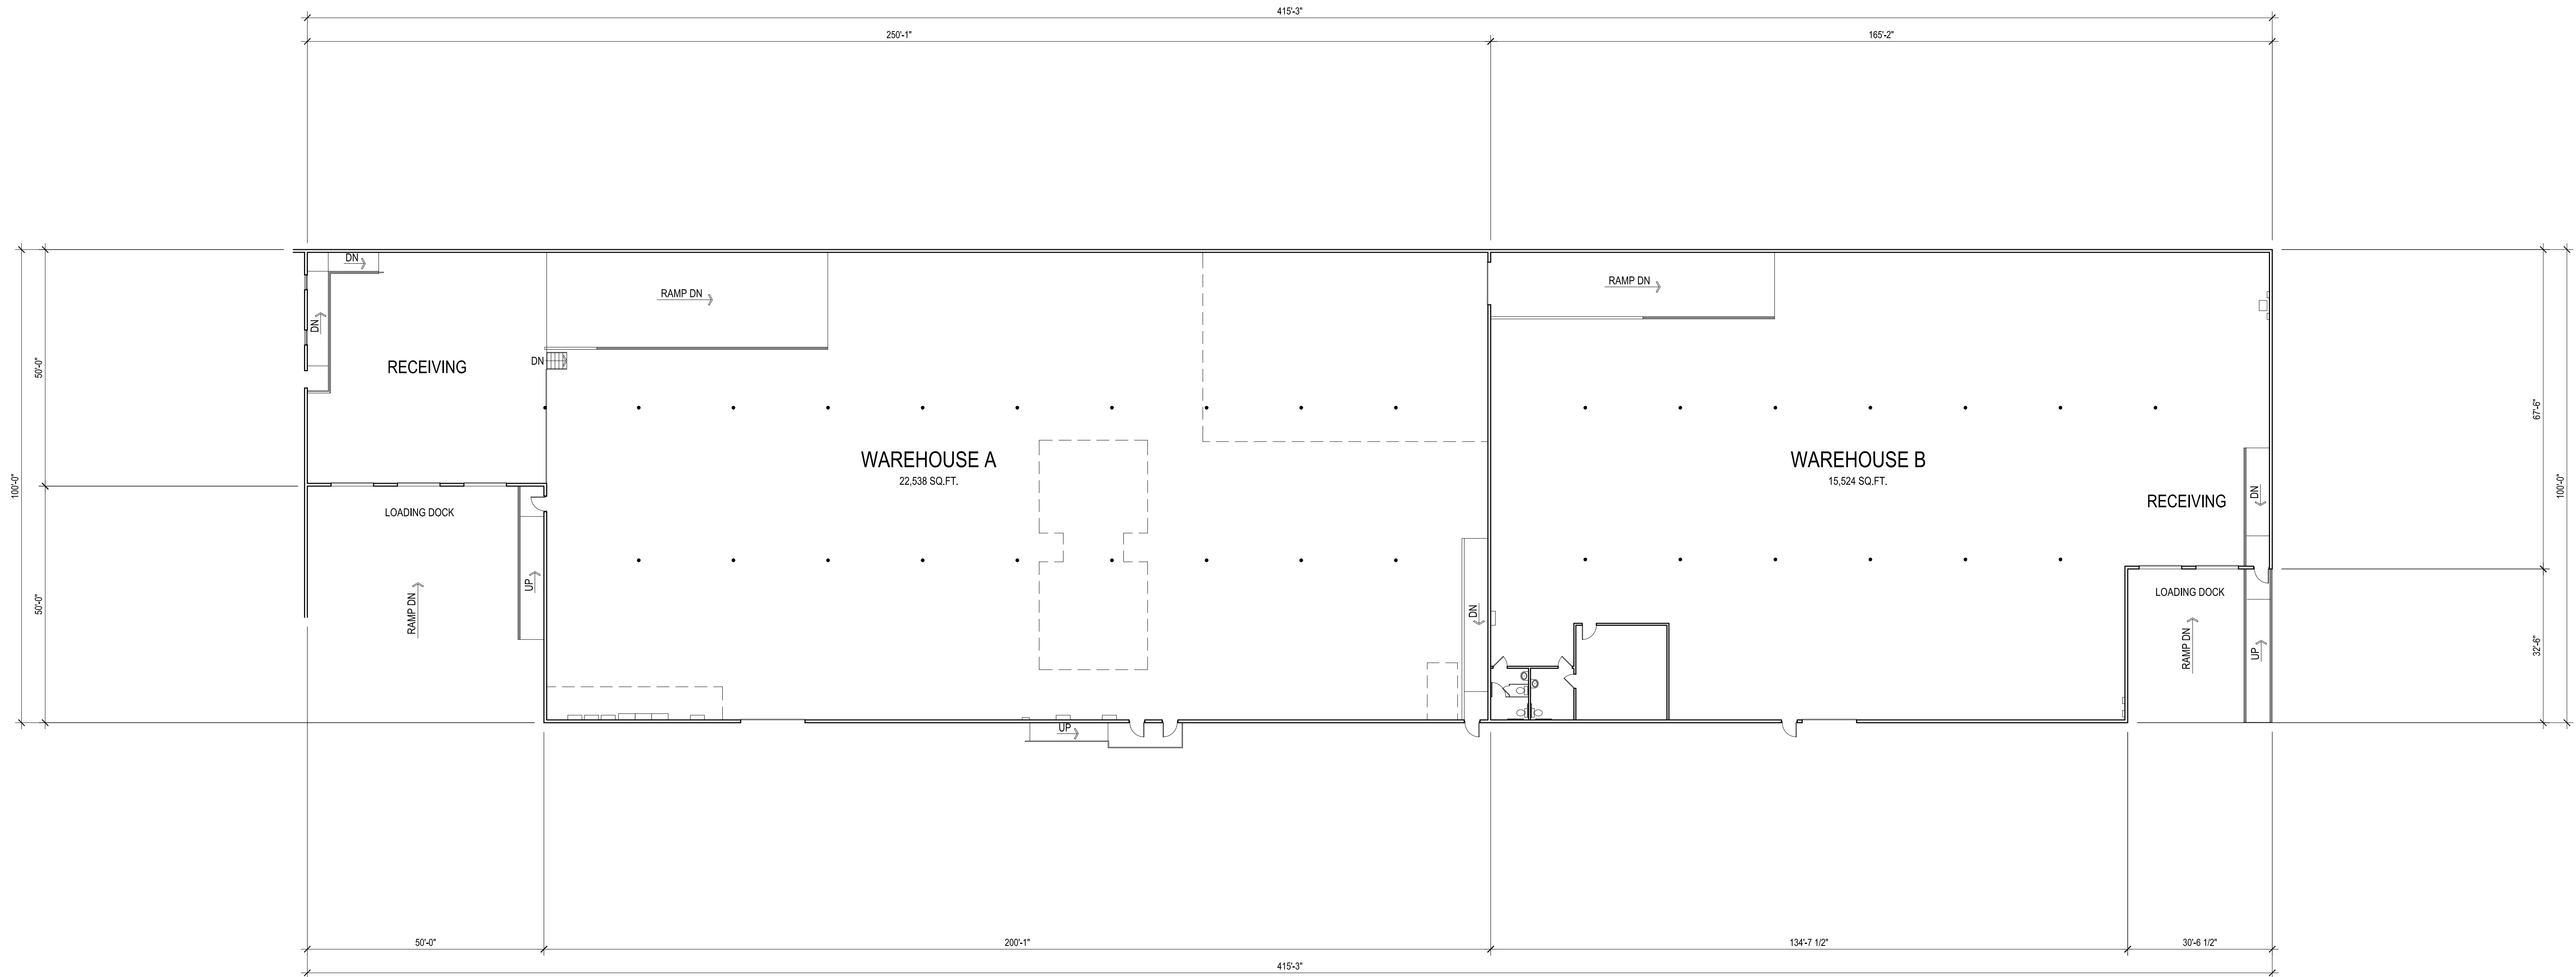

**AS-BUILT FLOOR PLAN**

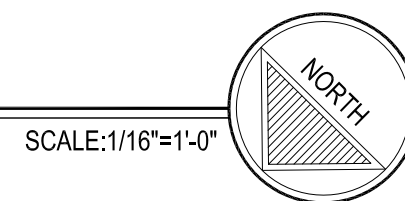

**REVISIONS**


**SHEET TITLE**

**AS-BUILT FLOOR PLAN WAREHOUSE "A" & "B"**

SHEET NO. **A2.0**

PROJECT	21019
DATE	06 / 04 / 2021
SCALE	AS SHOWN
DRAWN BY	O.T.


NOTE: ALL DIMENSIONS AND CONDITIONS SHOWN ON PLAN SHALL BE VERIFIED IN THE FIELD. ANY DISCREPANCIES SHALL BE COMMUNICATED TO THE DESIGNER PRIOR TO THE COMMENCEMENT OF ANY PROPOSED WORK


DESIGNER:  
**TIRADO DESIGN ASSOCIATES, INC.**  
 7562 CHAMINADE AVENUE  
 WEST HILLS, CA 91304

PROJECT:  
**WAREHOUSE AS-BUILT PLAN**  
 12432 FOOTHILL BLVD  
 SYLMAR, CA 91342

THE DRAWINGS AND SPECIFICATIONS ARE THE PROPERTY AND COPYRIGHT OF THE DESIGNER AND SHALL NOT BE USED ON ANY OTHER WORK EXCEPT BY WRITTEN AGREEMENT WITH THE DESIGNER. WRITTEN DIMENSIONS SHALL BE VERIFIED ON THE JOB SITE. DISCREPANCIES SHALL BE BROUGHT TO THE ATTENTION OF THE DESIGNER PRIOR TO THE COMMENCEMENT OF ANY WORK.

**NOTES**

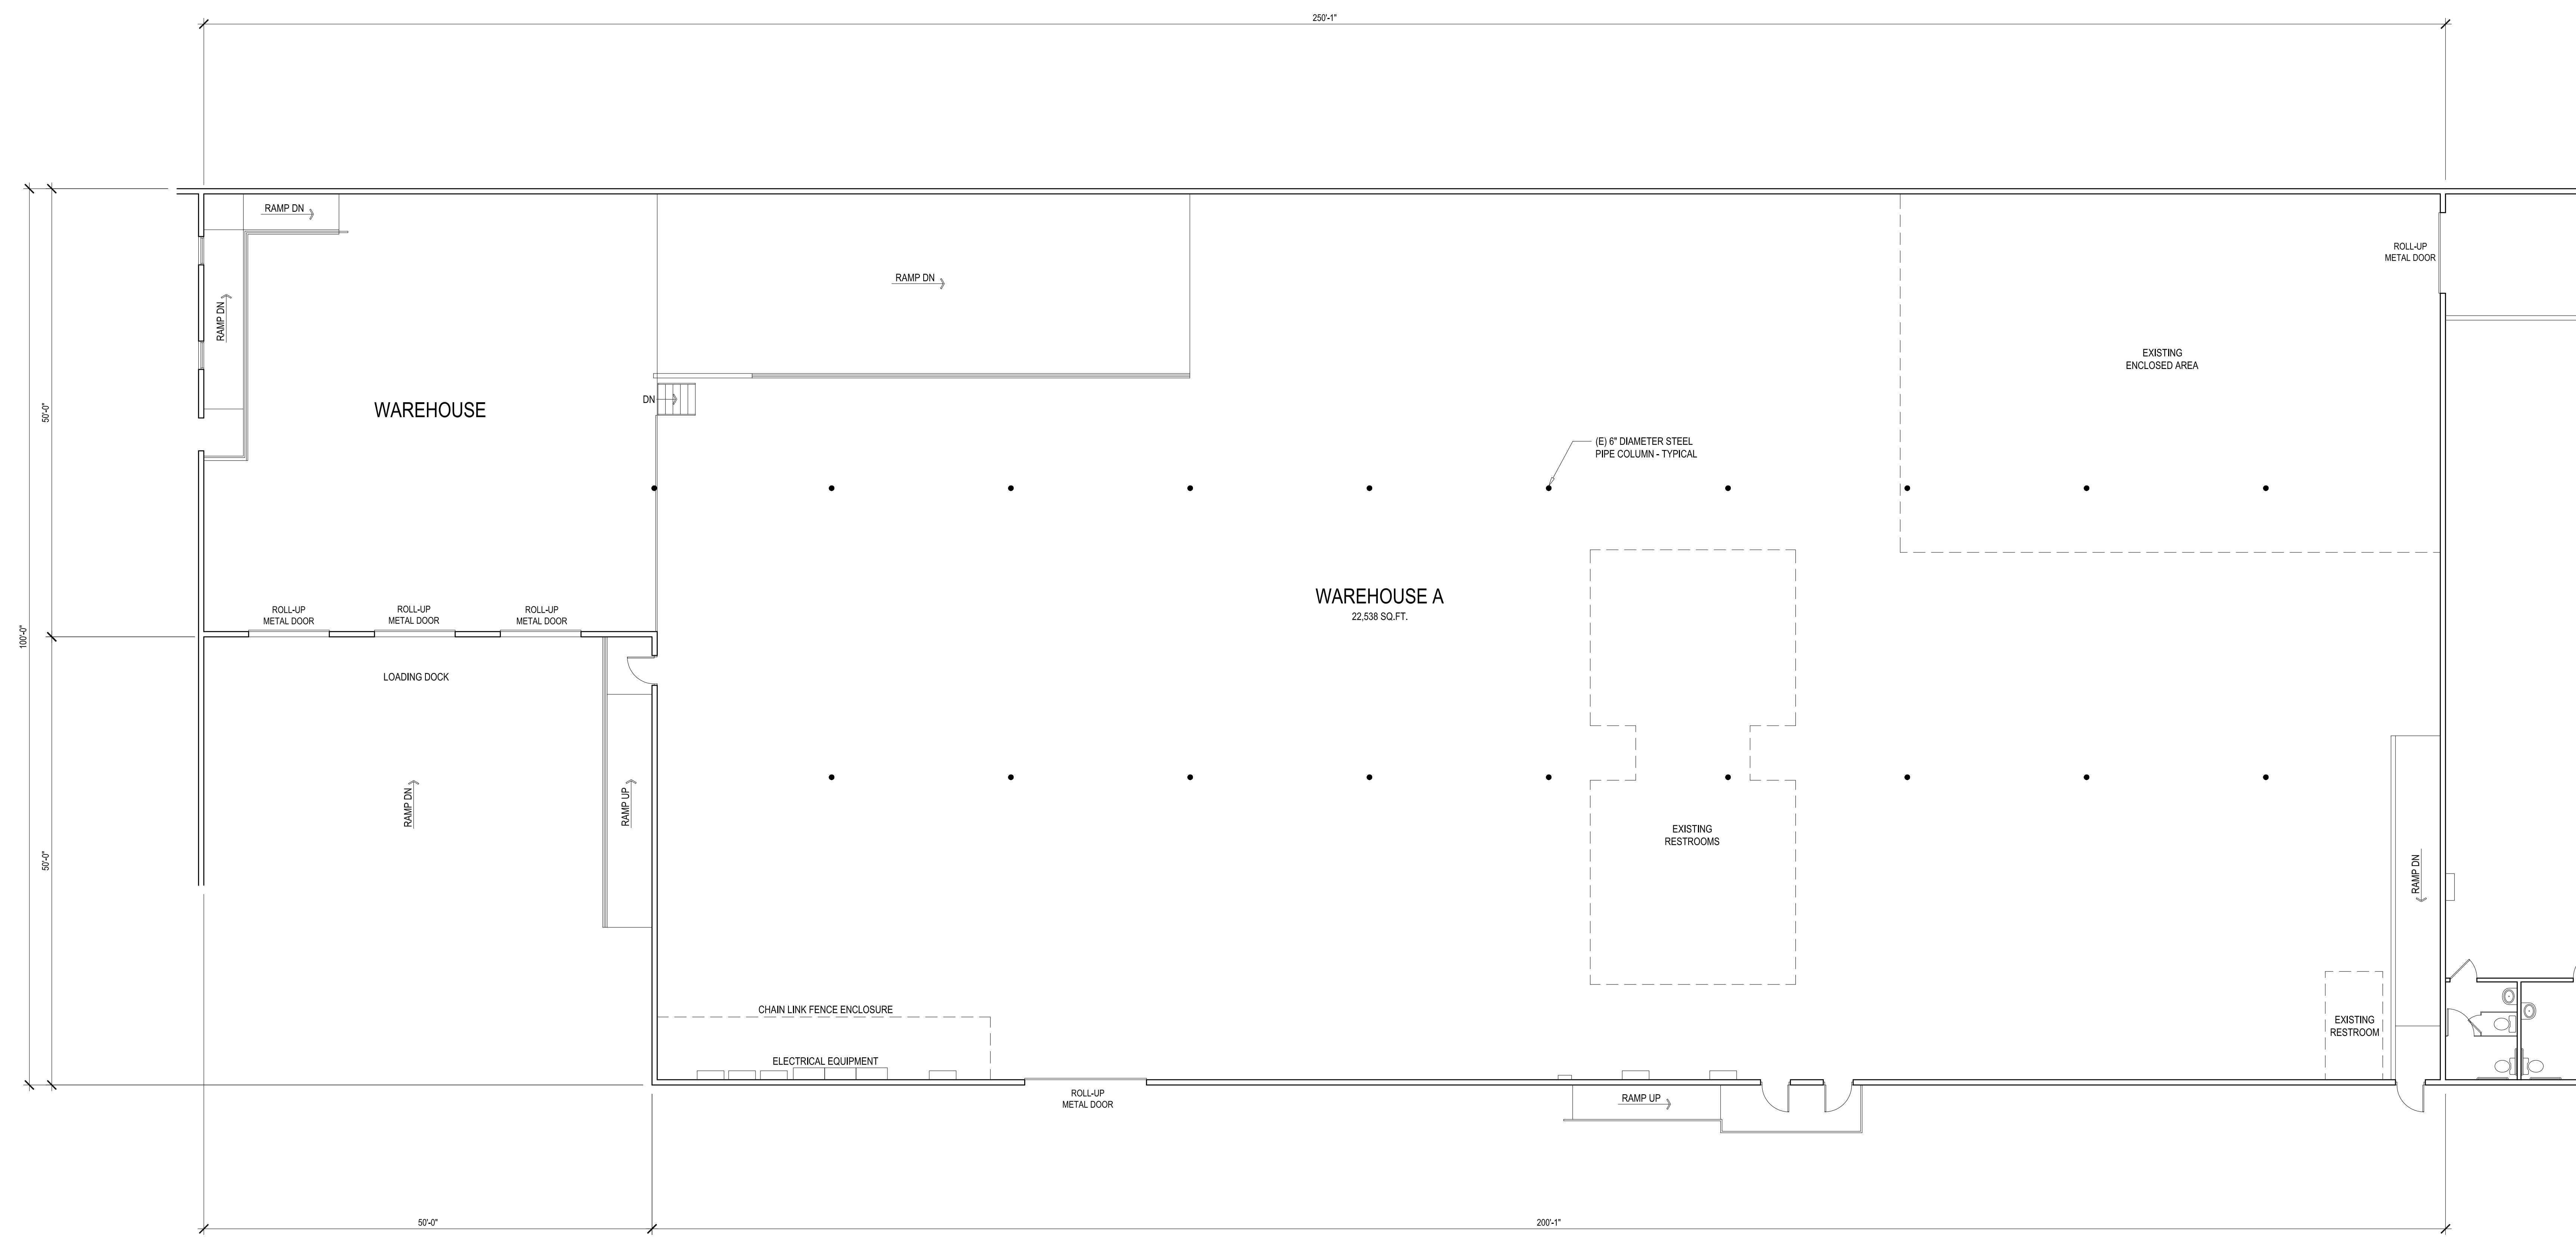

**AS-BUILT FLOOR PLAN - WAREHOUSE "A"**  
 SCALE: 1/8"=1'-0" 

**REVISIONS**


**SHEET TITLE**

**AS-BUILT FLOOR PLAN  
 WAREHOUSE "A"**

SHEET NO.  
**A2.1**


PROJECT	21019
DATE	06 / 04 / 2021
SCALE	AS SHOWN
DRAWN BY	O.T.

NOTE: ALL DIMENSIONS AND CONDITIONS SHOWN ON PLAN SHALL BE VERIFIED IN THE FIELD. ANY DISCREPANCIES SHALL BE COMMUNICATED TO THE DESIGNER PRIOR TO THE COMMENCEMENT OF ANY PROPOSED WORK

DESIGNER:  
**TIRADO DESIGN ASSOCIATES, INC.**  
 7562 CHAMINADE AVENUE  
 WEST HILLS, CA 91304

PROJECT:  
**WAREHOUSE AS-BUILT PLAN**  
 12432 FOOTHILL BLVD  
 SYLMAR, CA 91342

THE DRAWINGS AND SPECIFICATIONS ARE THE PROPERTY AND COPYRIGHT OF THE DESIGNER AND SHALL NOT BE USED ON ANY OTHER WORK EXCEPT BY WRITTEN AGREEMENT WITH THE DESIGNER. WRITTEN DIMENSIONS SHALL BE VERIFIED ON THE JOB SITE. DISCREPANCIES SHALL BE BROUGHT TO THE ATTENTION OF THE DESIGNER PRIOR TO THE COMMENCEMENT OF ANY WORK.

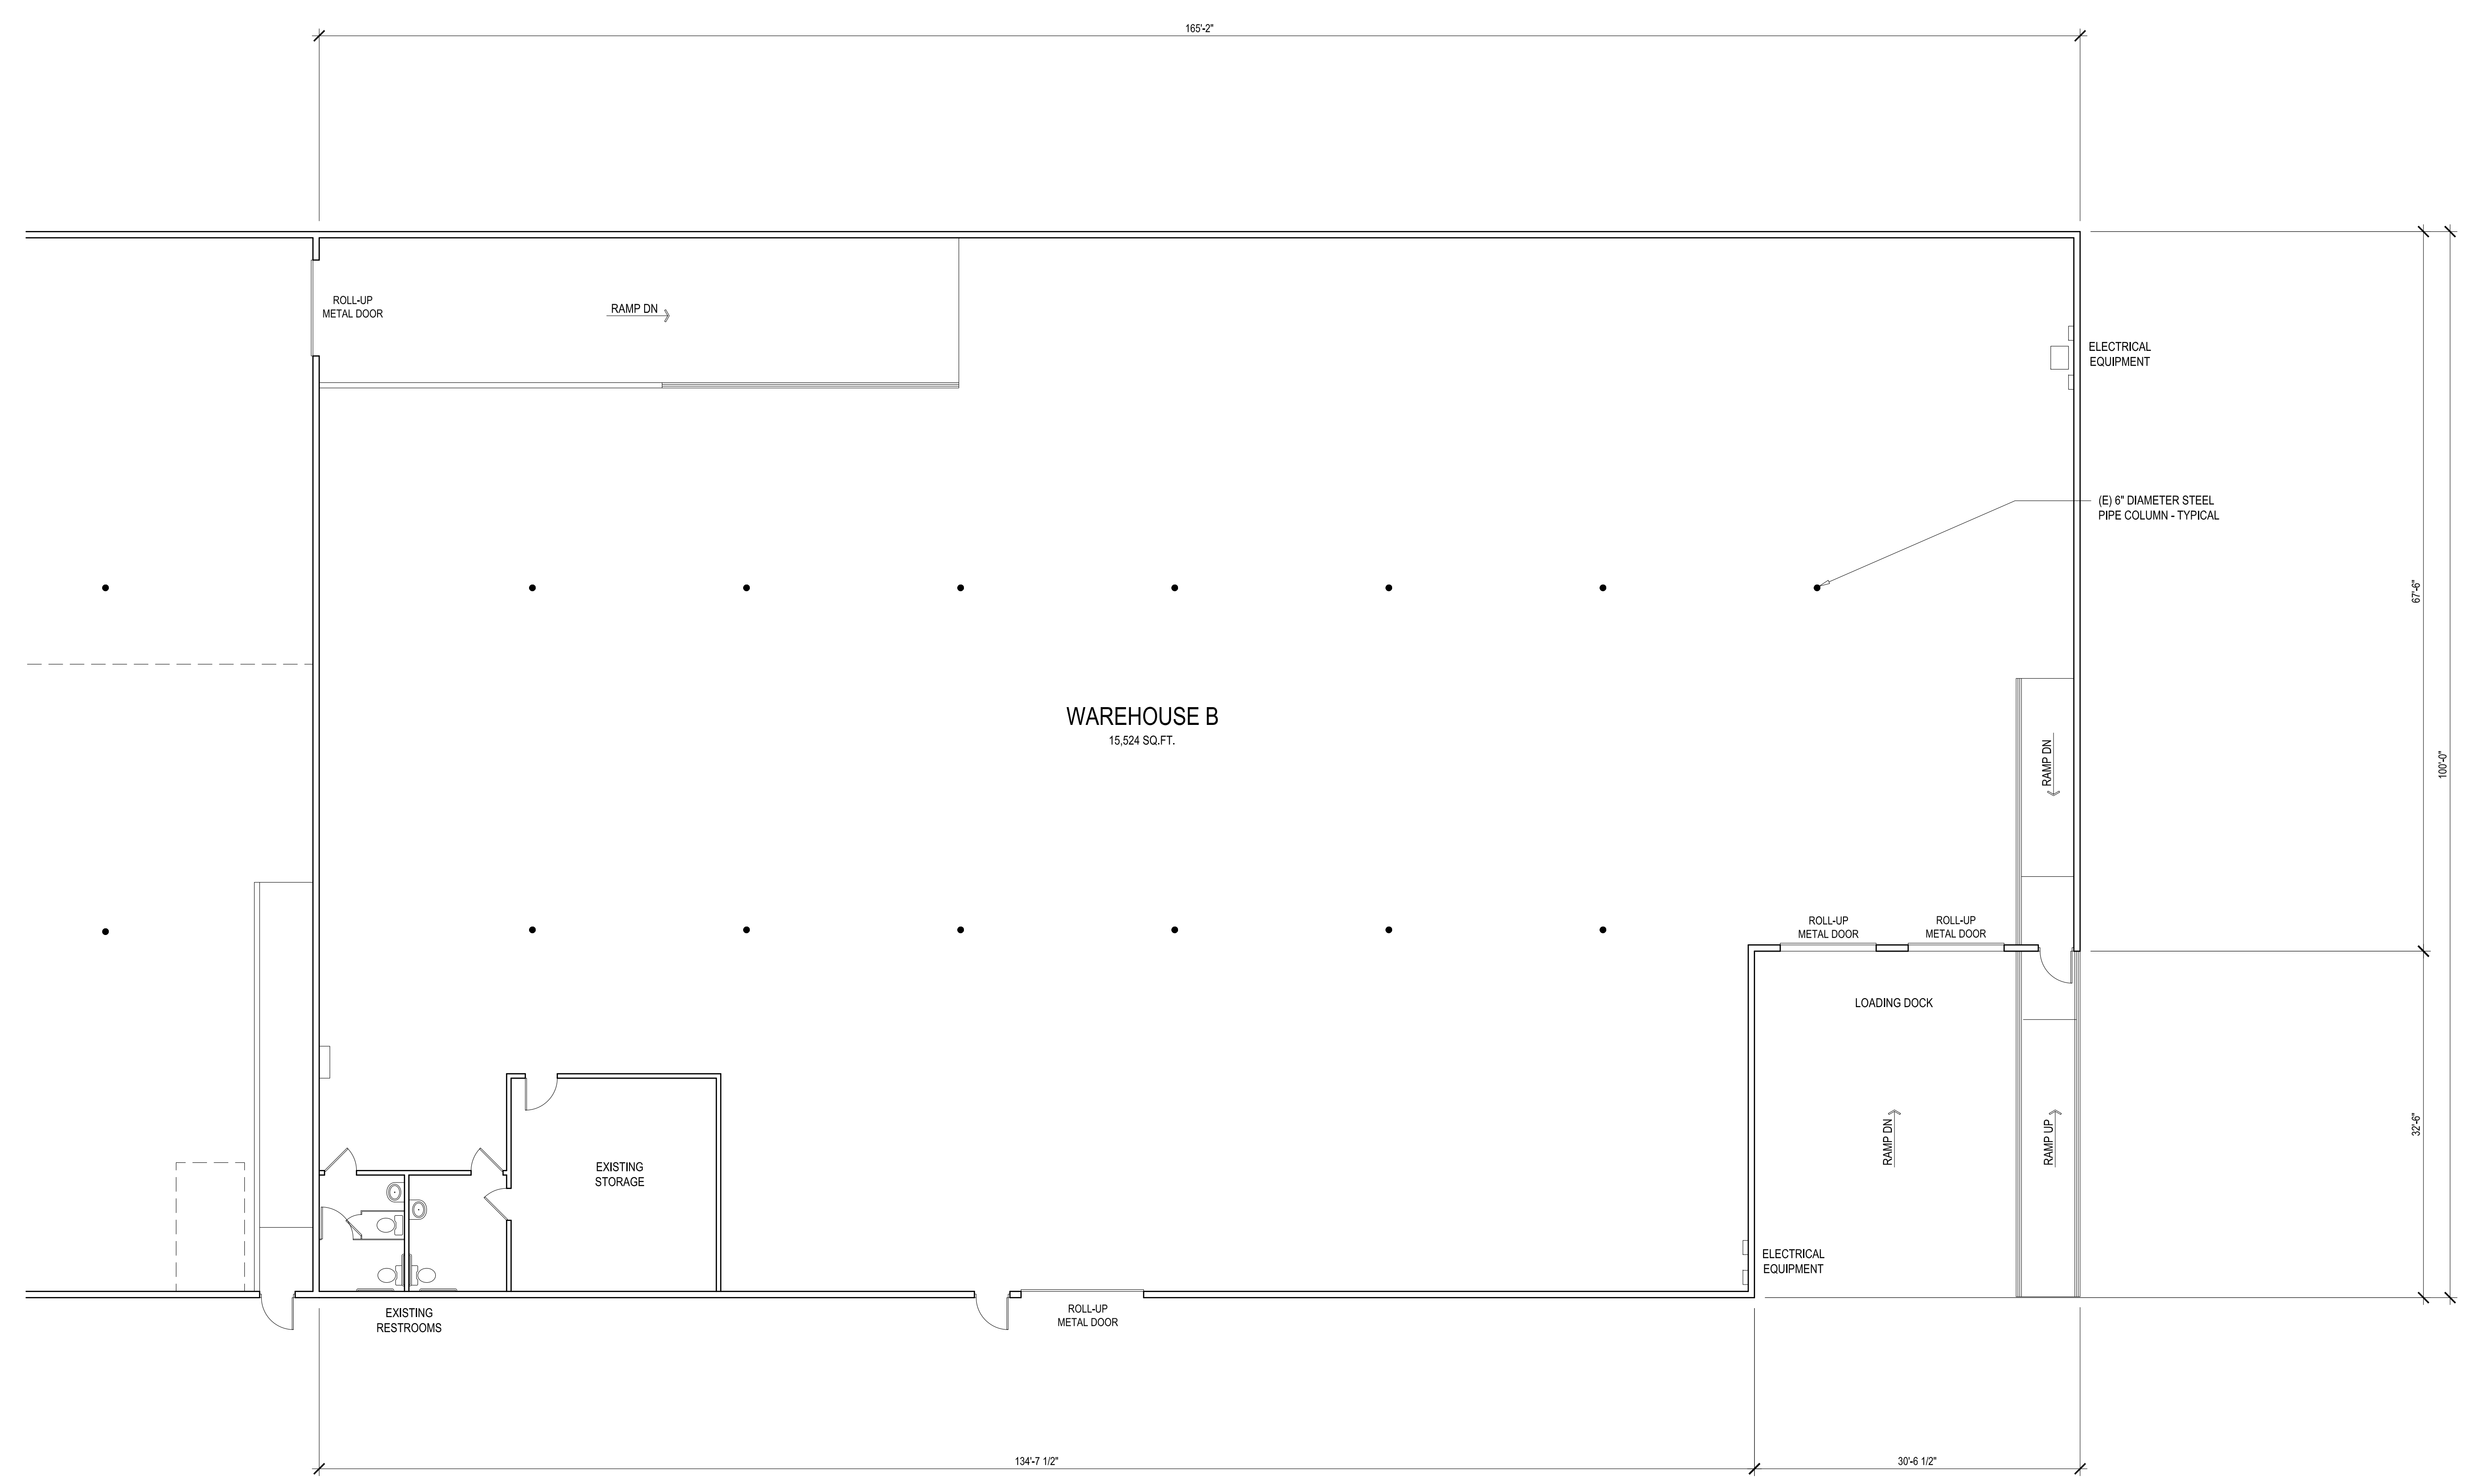

NOTES

REVISIONS



AS-BUILT FLOOR PLAN - WAREHOUSE "B"  
 SCALE: 1/8"=1'-0" 

SHEET TITLE  
**AS-BUILT FLOOR PLAN WAREHOUSE "B"**

SHEET NO.  
**A2.2**

PROJECT	21019
DATE	06 / 04 / 2021
SCALE	AS SHOWN
DRAWN BY	O.T.

NOTE: ALL DIMENSIONS AND CONDITIONS SHOWN ON PLAN SHALL BE VERIFIED IN THE FIELD. ANY DISCREPANCIES SHALL BE COMMUNICATED TO THE DESIGNER PRIOR TO THE COMMENCEMENT OF ANY PROPOSED WORK

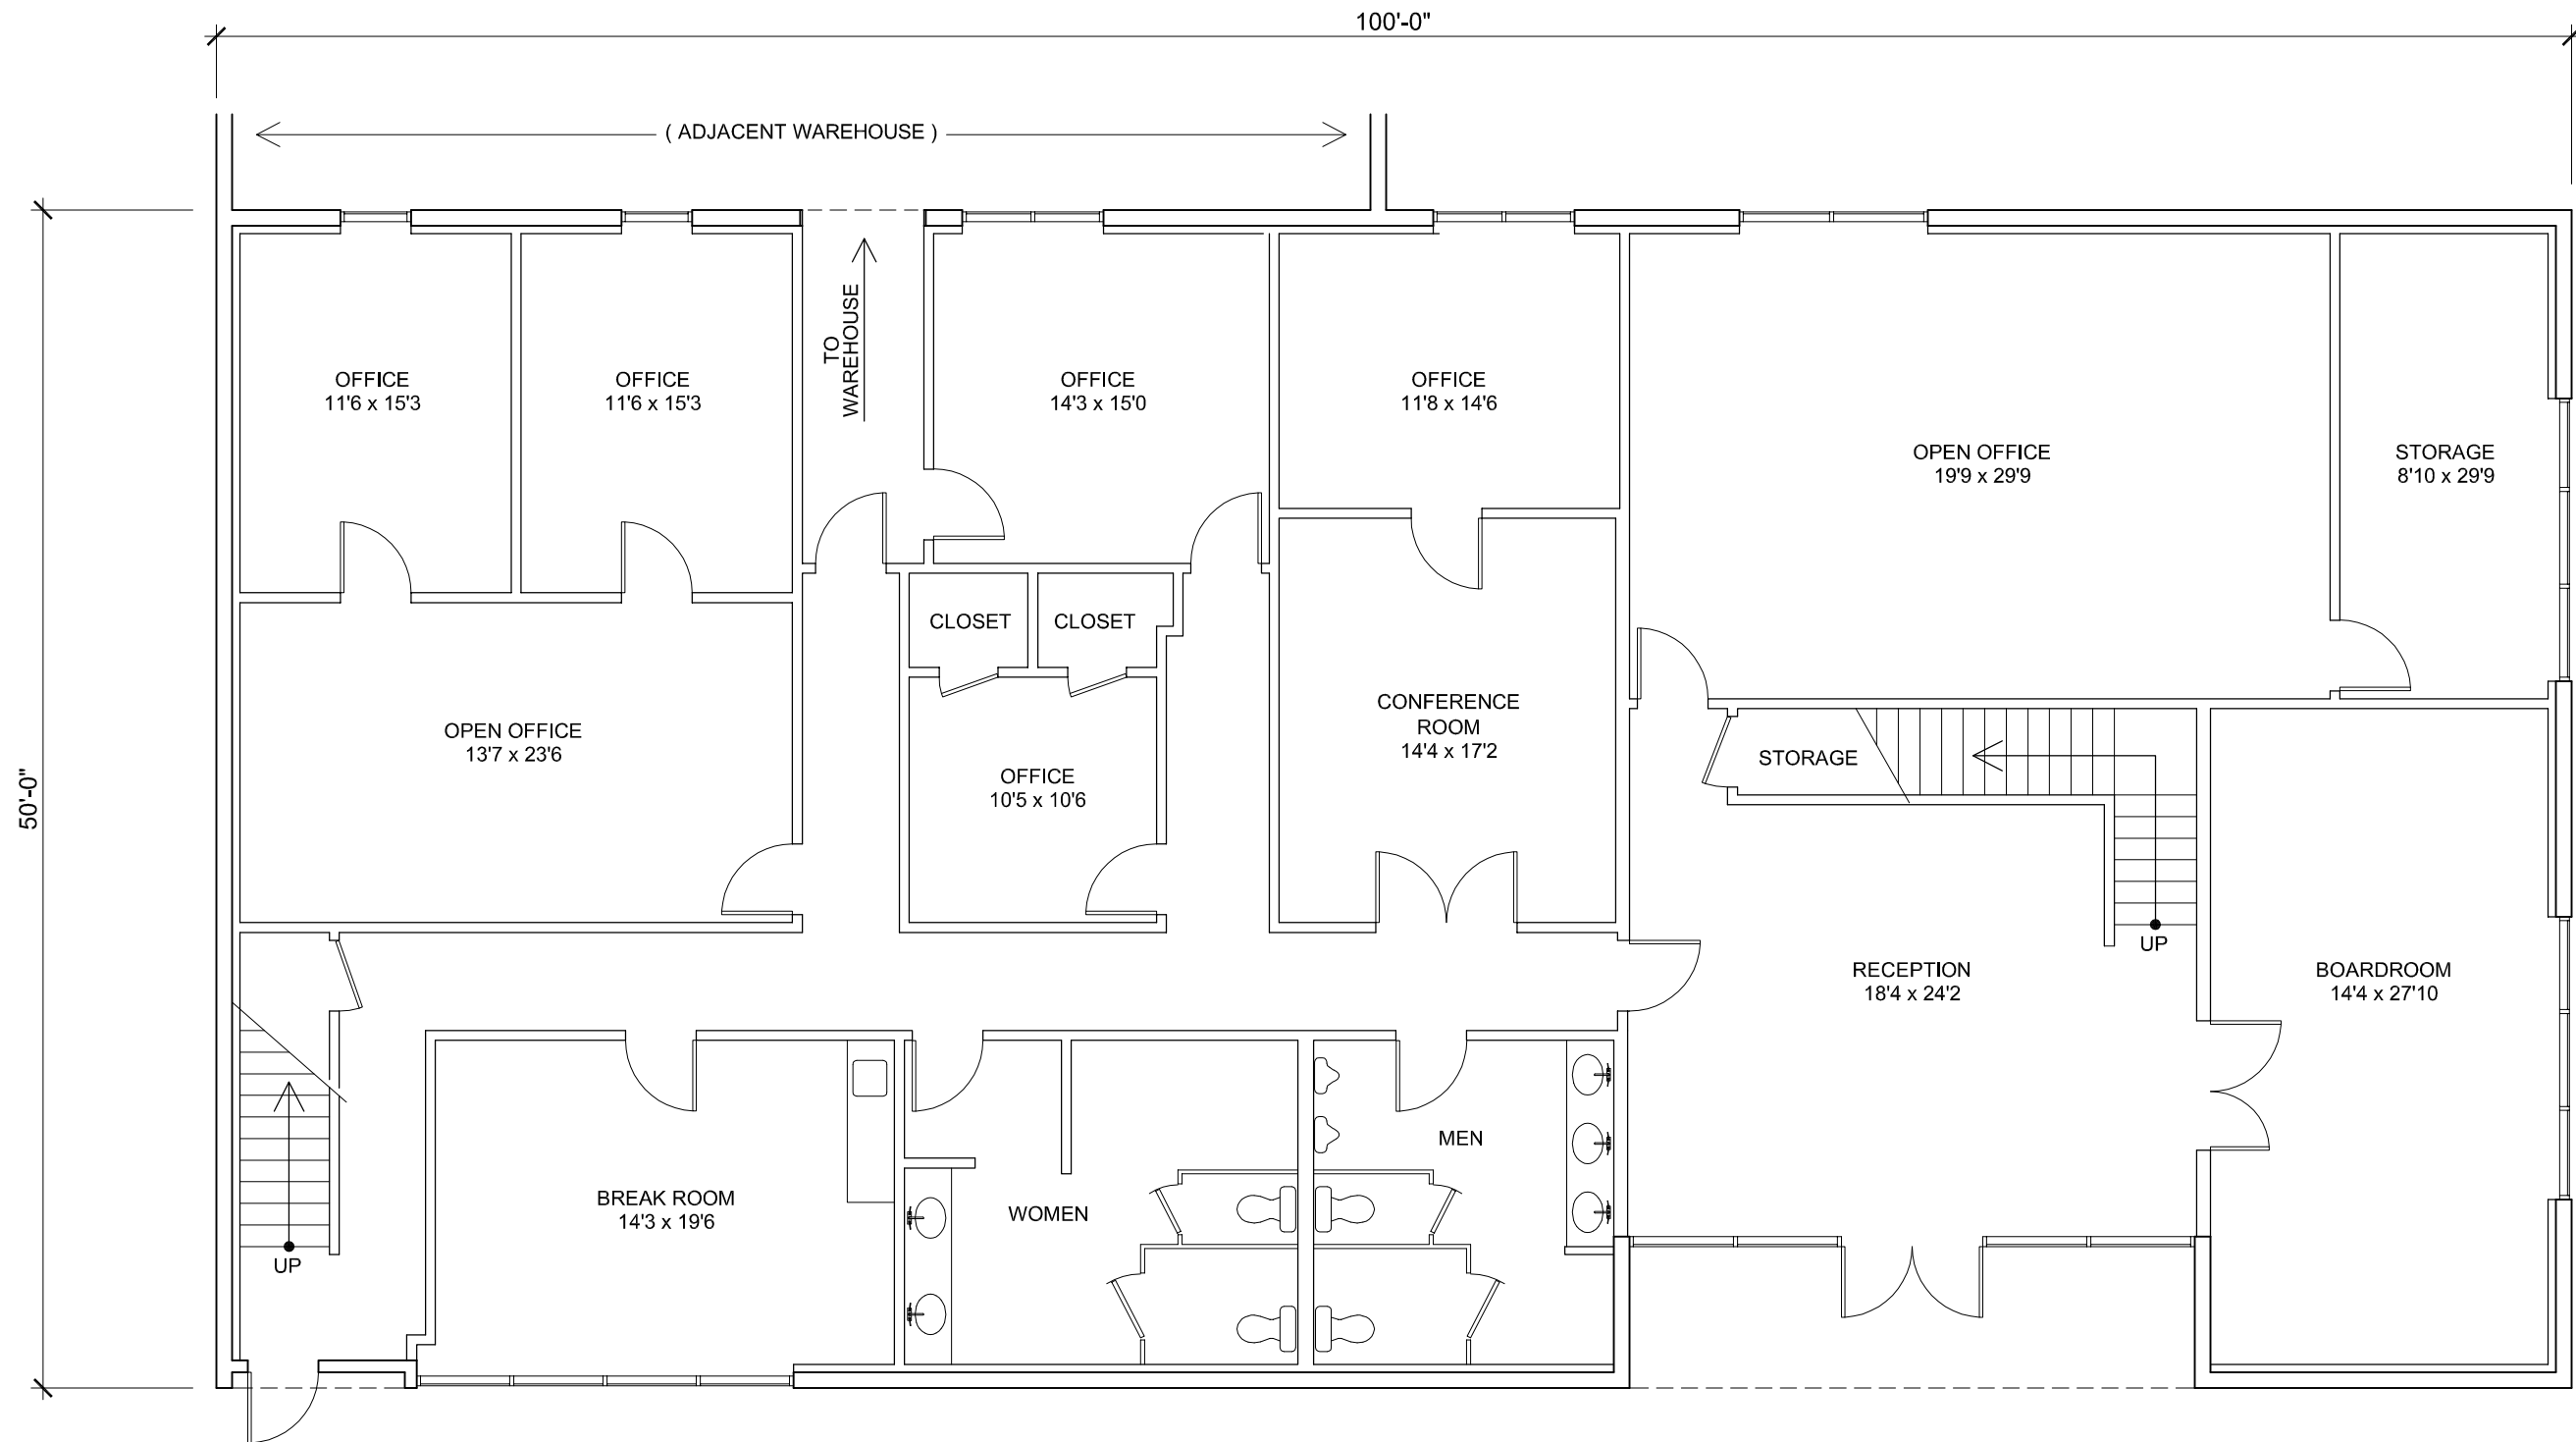

**1ST FLOOR**



12432 FOOTHILL BLVD.  
 1ST FLOOR  
 SYLMAR, CA 91343

DATE: 09-11-2019 SCALE: 1/8" = 1'-0"

CONTACT: Rick Sonnenleiter / Javier Tuma


SHEET TITLE: AS-BUILT PLAN

SHEET NUMBER:

**AB-1.1**

5000 SQ. FT.  
 EACH FLOOR

-(INDICATED ROOM SIZES ARE APPROXIMATE)

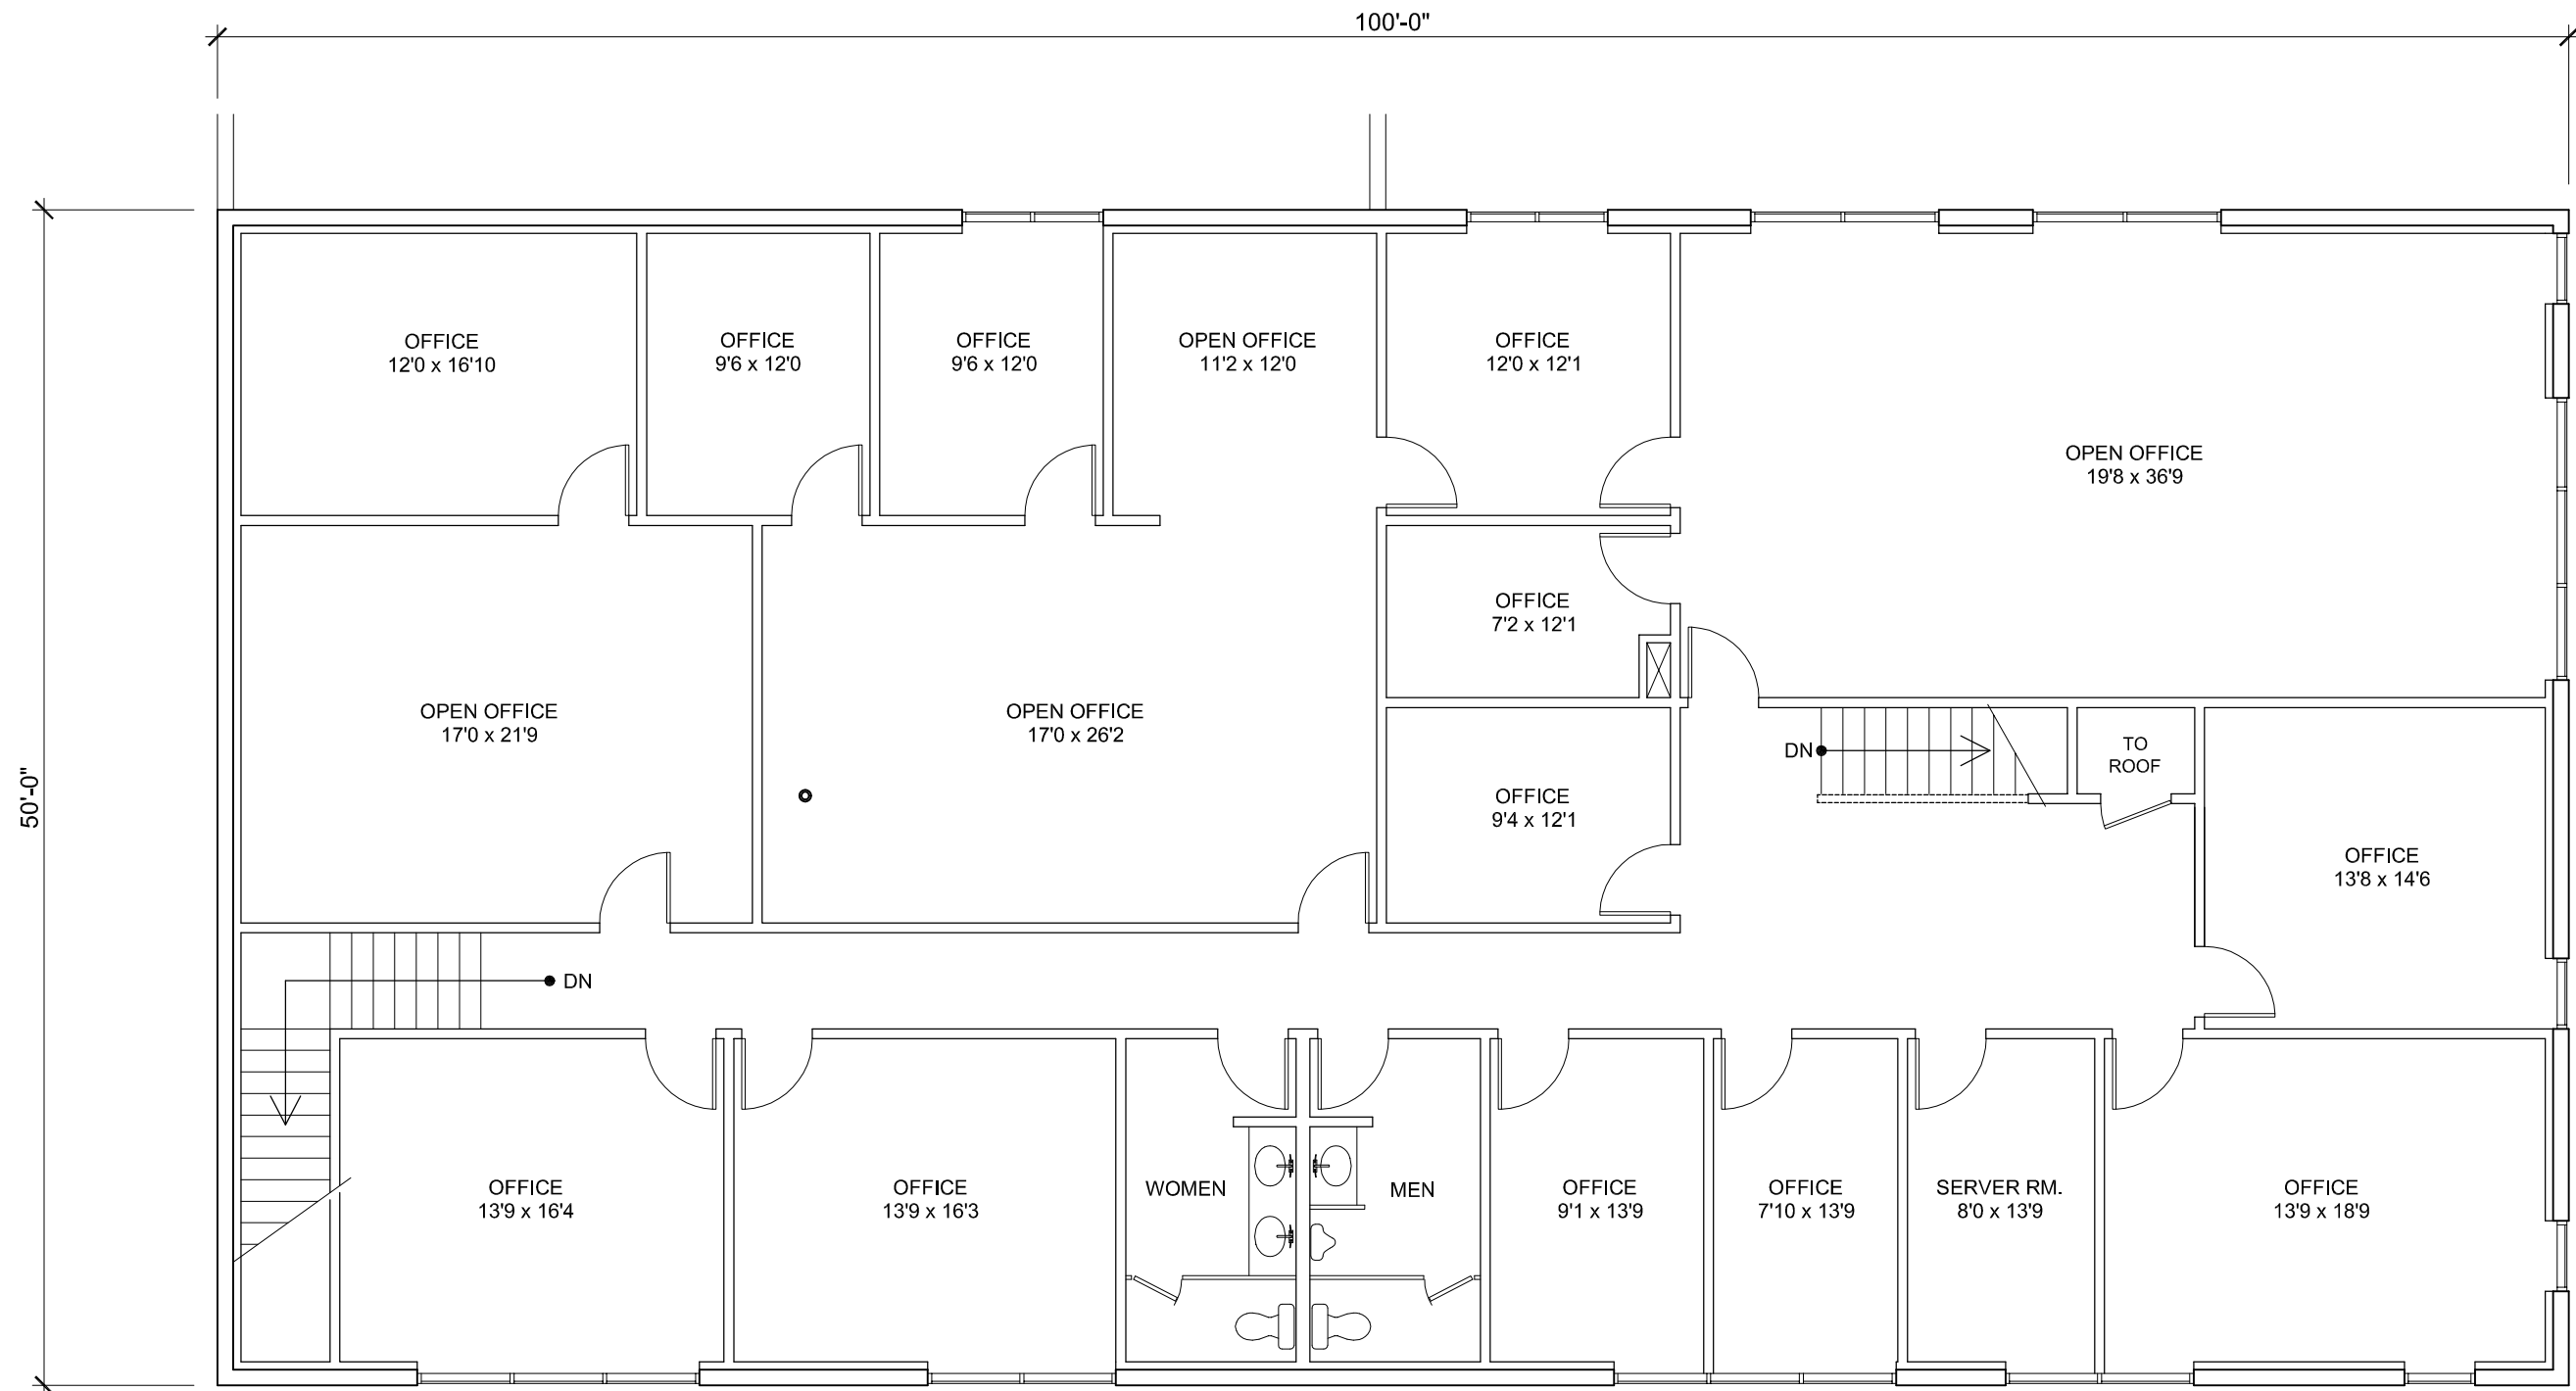

**2ND FLOOR**



12432 FOOTHILL BLVD. 2ND FLOOR SYLMAR, CA 91343	DATE: 09-11-2019	SCALE: 1/8" = 1'-0"
5000 SQ. FT. EACH FLOOR	CONTACT: Rick Sonnenleiter / Javier Tuma	
-(INDICATED ROOM SIZES ARE APPROXIMATE)	SHEET TITLE: <b>AS-BUILT PLAN</b>	
	SHEET NUMBER: <b>AB-1.2</b>	