

# Property Key




# AltSprings As Built Marketing Package

370 Northlake Blvd, Alt Springs, FL 32701, US

Building: 370

Suite: 1028

Sheet **E1**

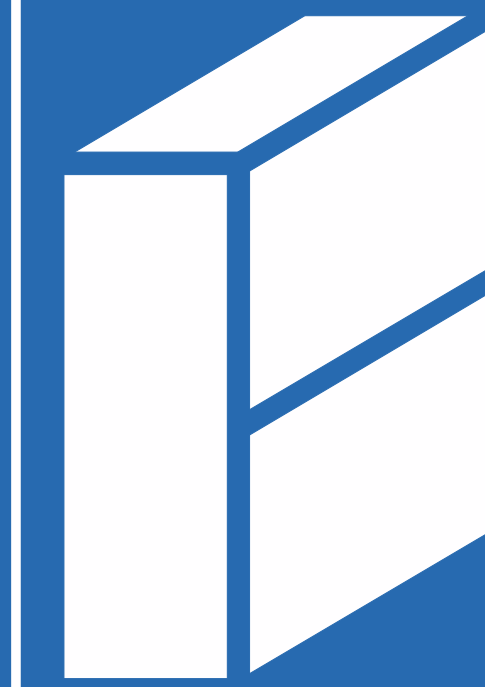

# BAY SPACE

Scale: Not to Scale  
Sheet Size: 42" x 30"  
Not For Construction

## Usable Square Foot Analysis

Office Area	9,750	100 %
Warehouse Area	0	0%
Total Area	9,750	

## Building Information

Deck Height:	17' - 2 1/2"
Clear Height:	8' - 9"
Ceiling Height:	7' - 11"
Sprinklered:	<input checked="" type="checkbox"/> Yes <input type="checkbox"/> No
Mechanical Area:	135 SQFT

