


1 **Reduced As-built**
Suite 706

Scale: 1/8" = 1'-0"

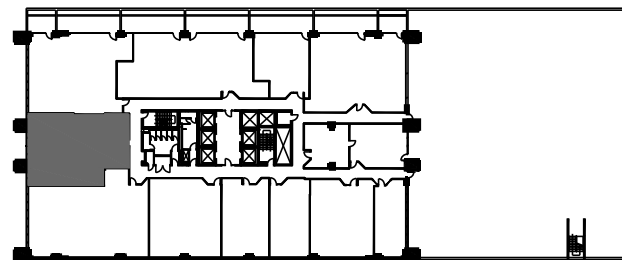

Proximity Plan

Suite 706

The Chancery

2,142 RSF