



# 150 GLOVER AVENUE

## HIGHLIGHTS


- Built-to-lease, plug and play office space
- Gross lease with flexible month-to-month terms
- \$32 per square foot
- High speed reliable commercial internet connectivity
- Located within a developing Live-Work-Play community
- Access to amenities on-site
- Walking distance to the Merritt 7 train station
- Accessible to Route 7, the Merritt Parkway, and I-95
- Access to the NRVT

## AVAILABILITY

1,563 SF of premier space



## AS BUILT FLOORPLAN

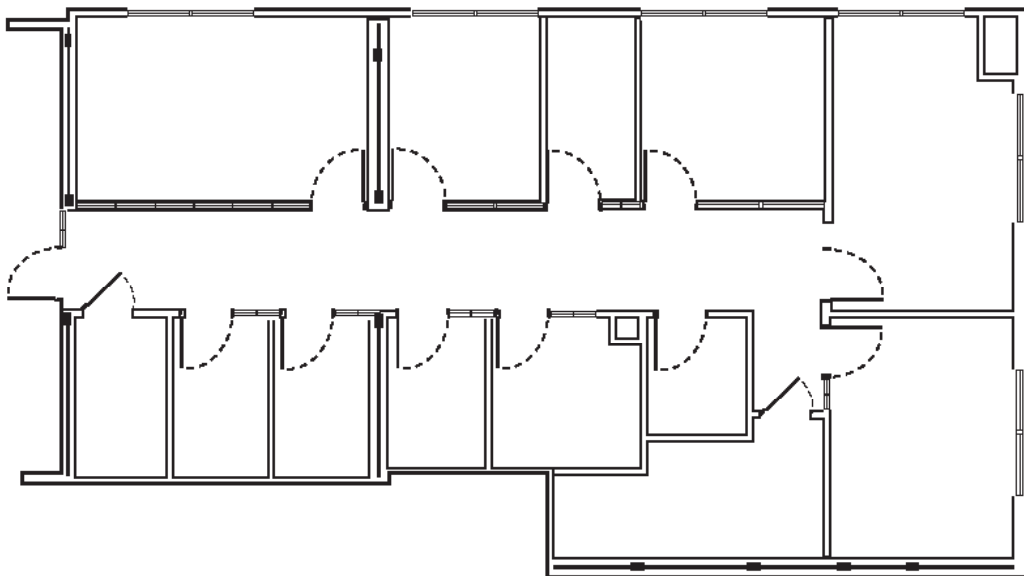

Please direct all inquiries to

Jay Lapham  
Senior Vice President of Commercial Leasing  
(203) 803-8801  
jlapham@bltooffice.com

Kurt Kuehner  
Senior Vice President of Commercial Office Leasing  
(203) 644-1583  
kurt@bltooffice.com