



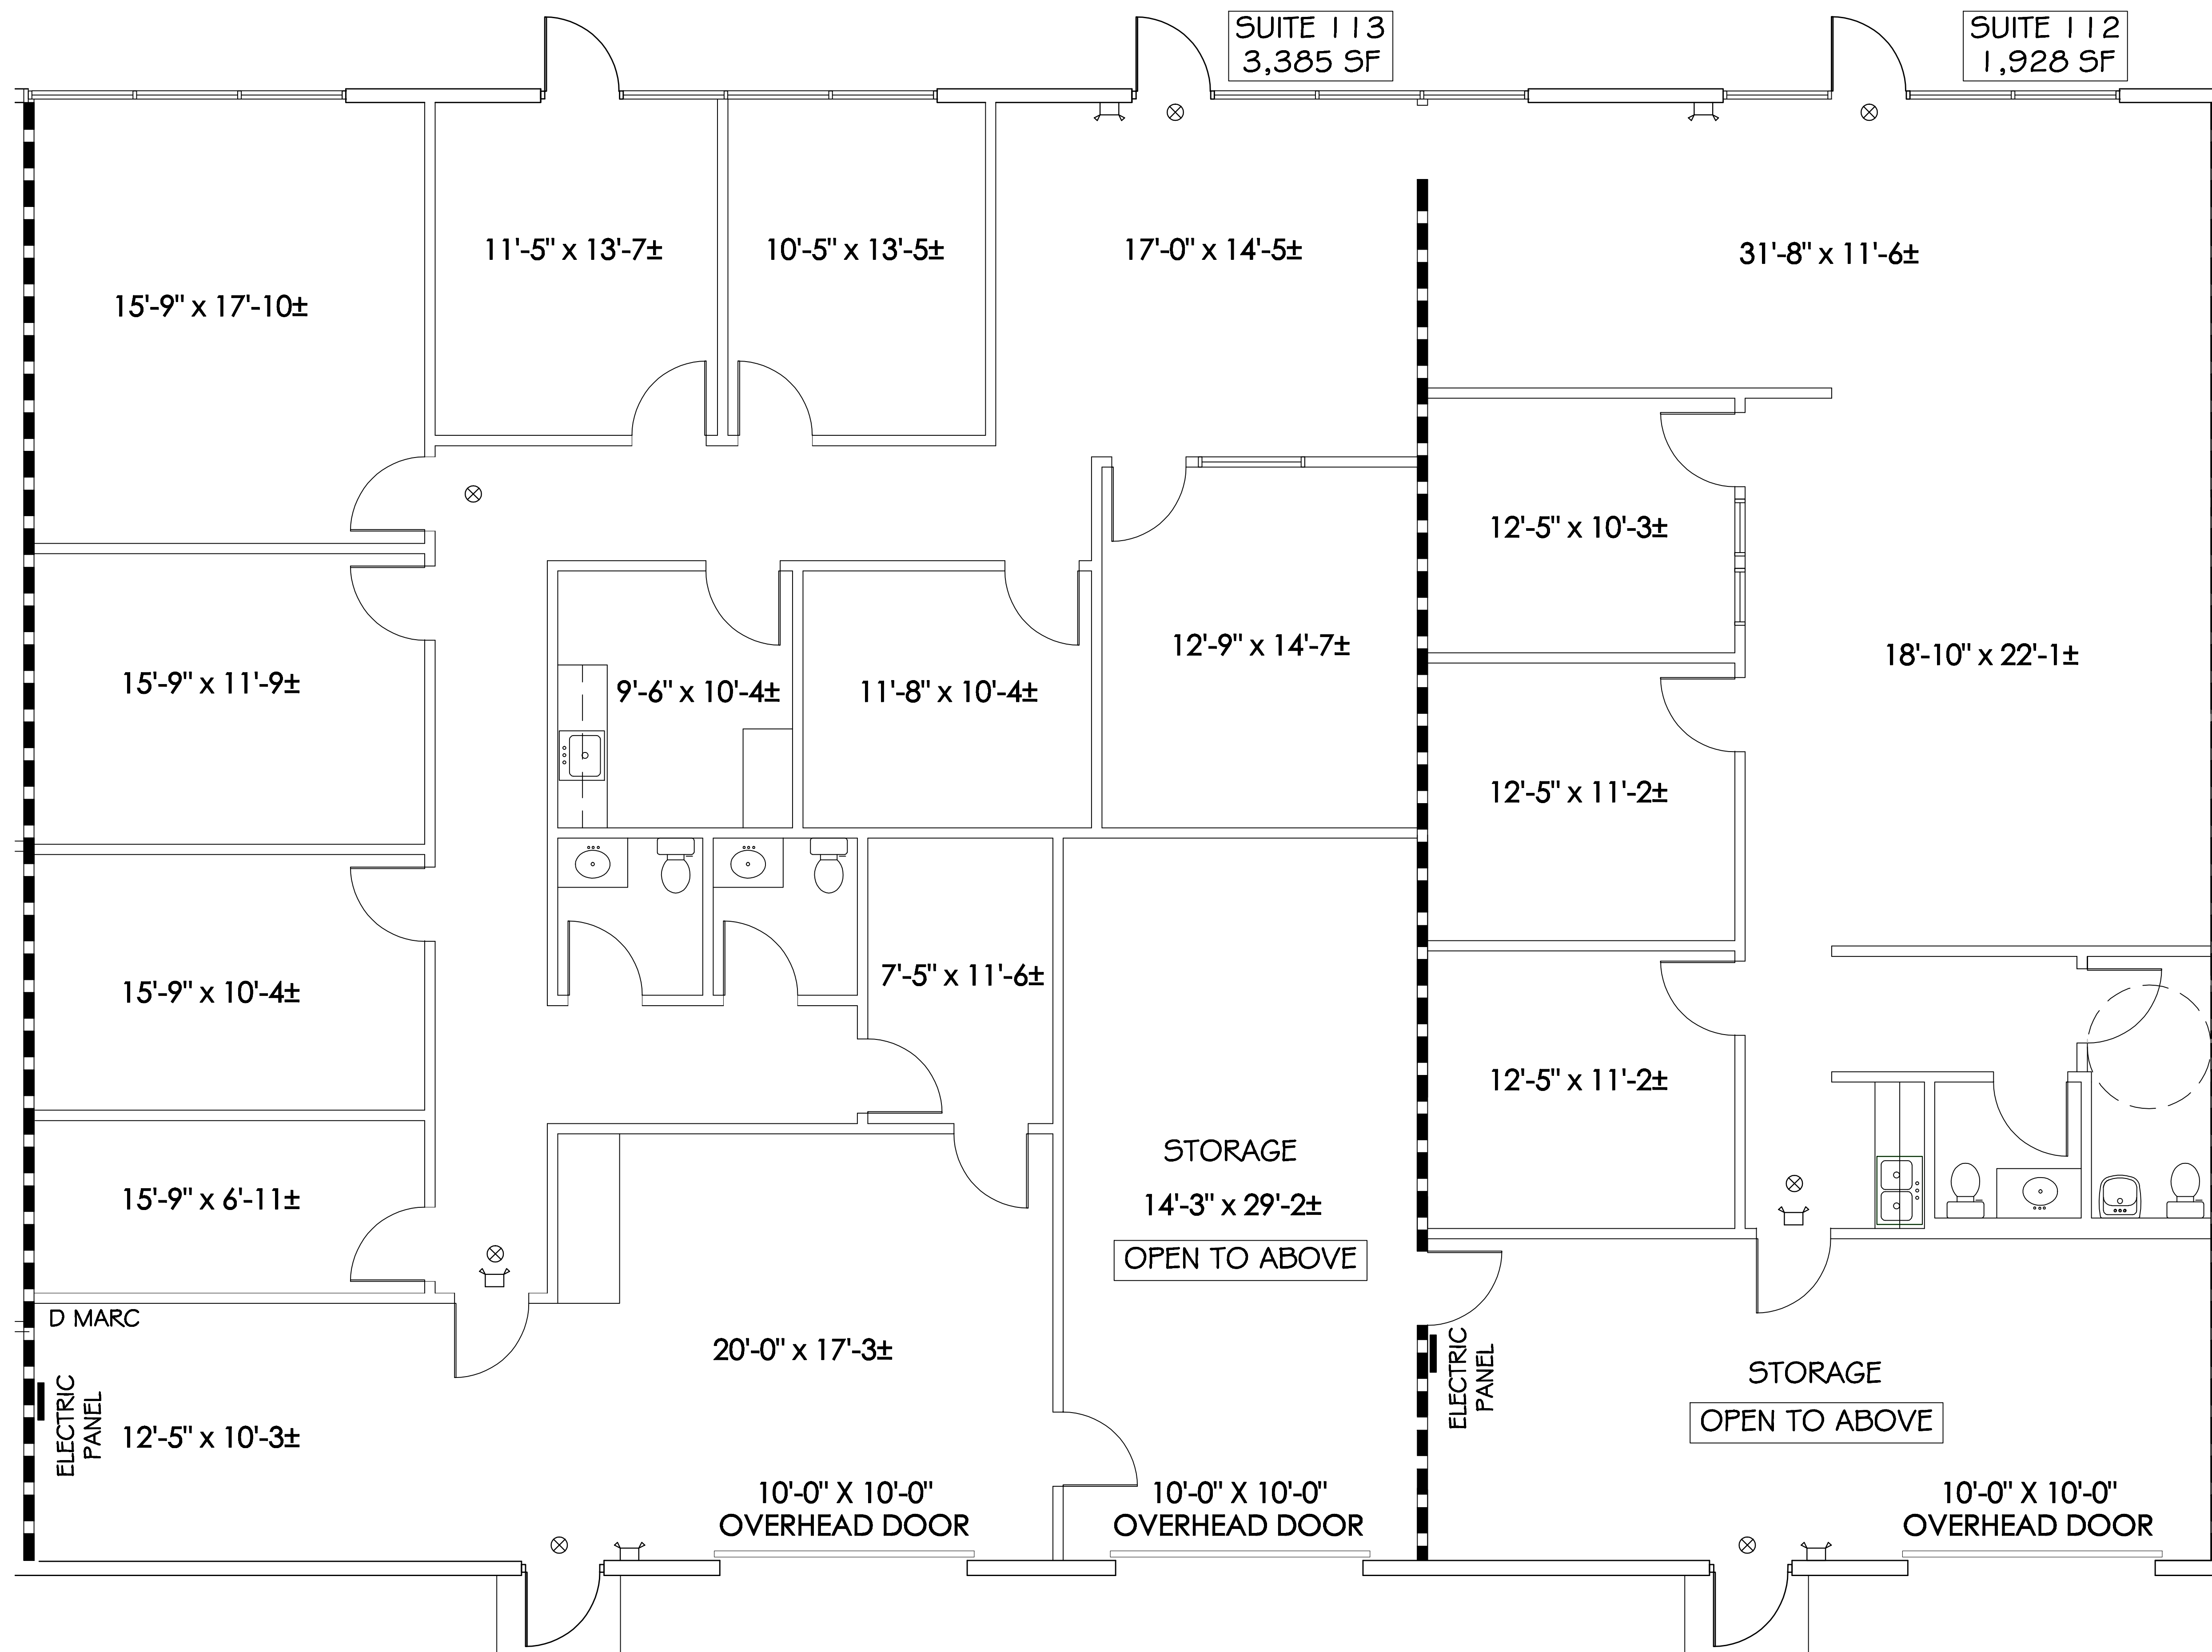

Z PROJECTS, LLC
1413 JACKSON RD.
KELLER, TX 76262
817.875.1506
www.linkedin.com/in/davezobrist

KEY PLAN

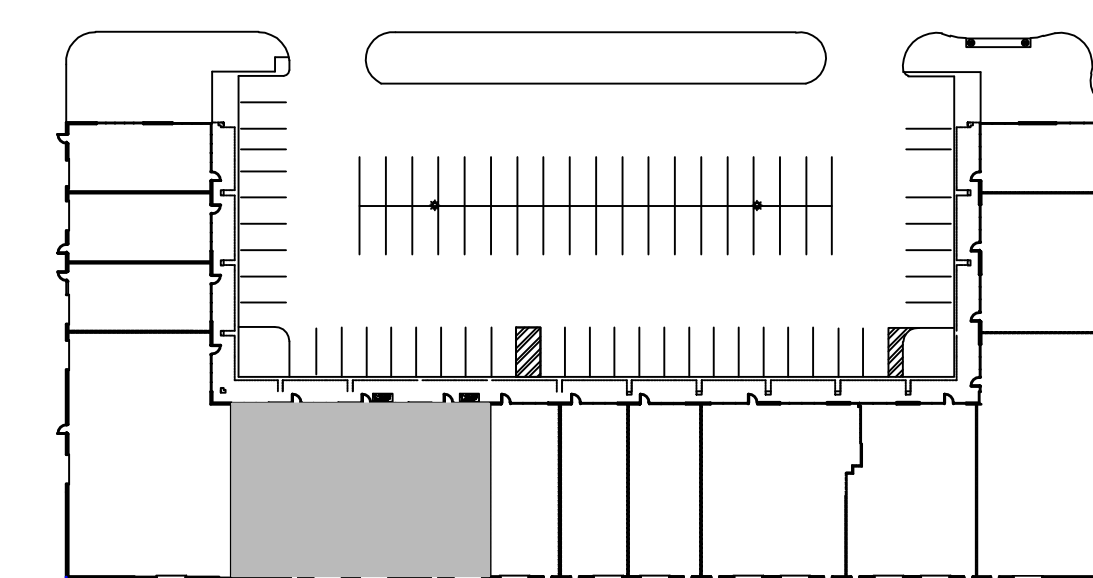

AREA OF WORK

ROBERT B. POWELL, CCIM
POWELL REALITY ADVISORS, LLC.
214-908-3488
Robert.Powell@PowellRealityAdvisors.com

AIRPORT PLAZA
SUITE 112 & 113 | 5,313 SF
4500 RATLIFF | ADDISON, TX 75001

AS BUILT 
06.29.2026