
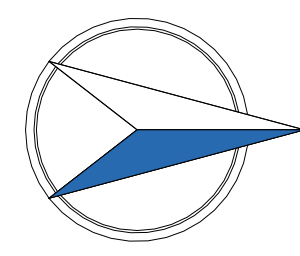


Property Key

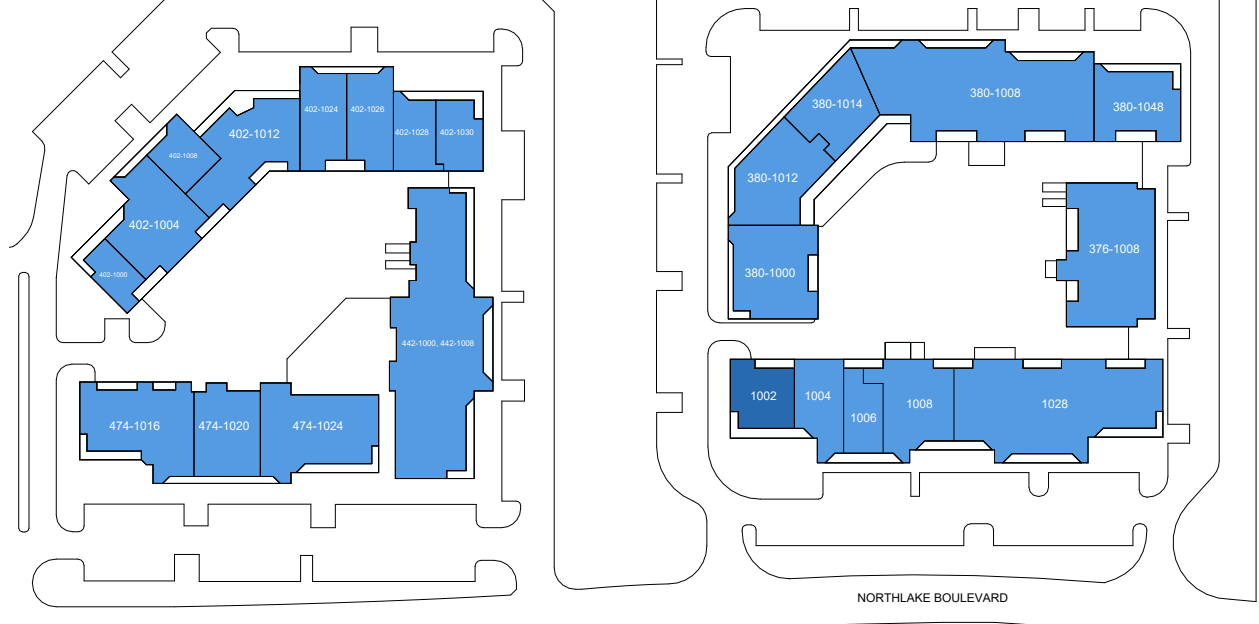

AltSprings As Built Marketing Package

370 Northlake Blvd, Alt Springs, FL 32701, US

Building: 370

Suite: 1002

Sheet **E1**

Scale: Not to Scale
Sheet Size: 42" x 30"
Not For Construction



BAY SPACE

Usable Square Foot Analysis

Office Area	21,428	100 %
Warehouse Area	0	0%
Total Area	21,428	

Building Information

Deck Height:	17' - 2 1/2"
Clear Height:	8' - 9"
Ceiling Height:	7' - 11"
Sprinklered:	<input checked="" type="checkbox"/> Yes <input type="checkbox"/> No
Mechanical Area:	135 SQFT

