


5610 SOUTHWEST FREEWAY SUITE C
5610 SOUTHWEST FREEWAY, SUITE C
HOUSTON, TEXAS 77057

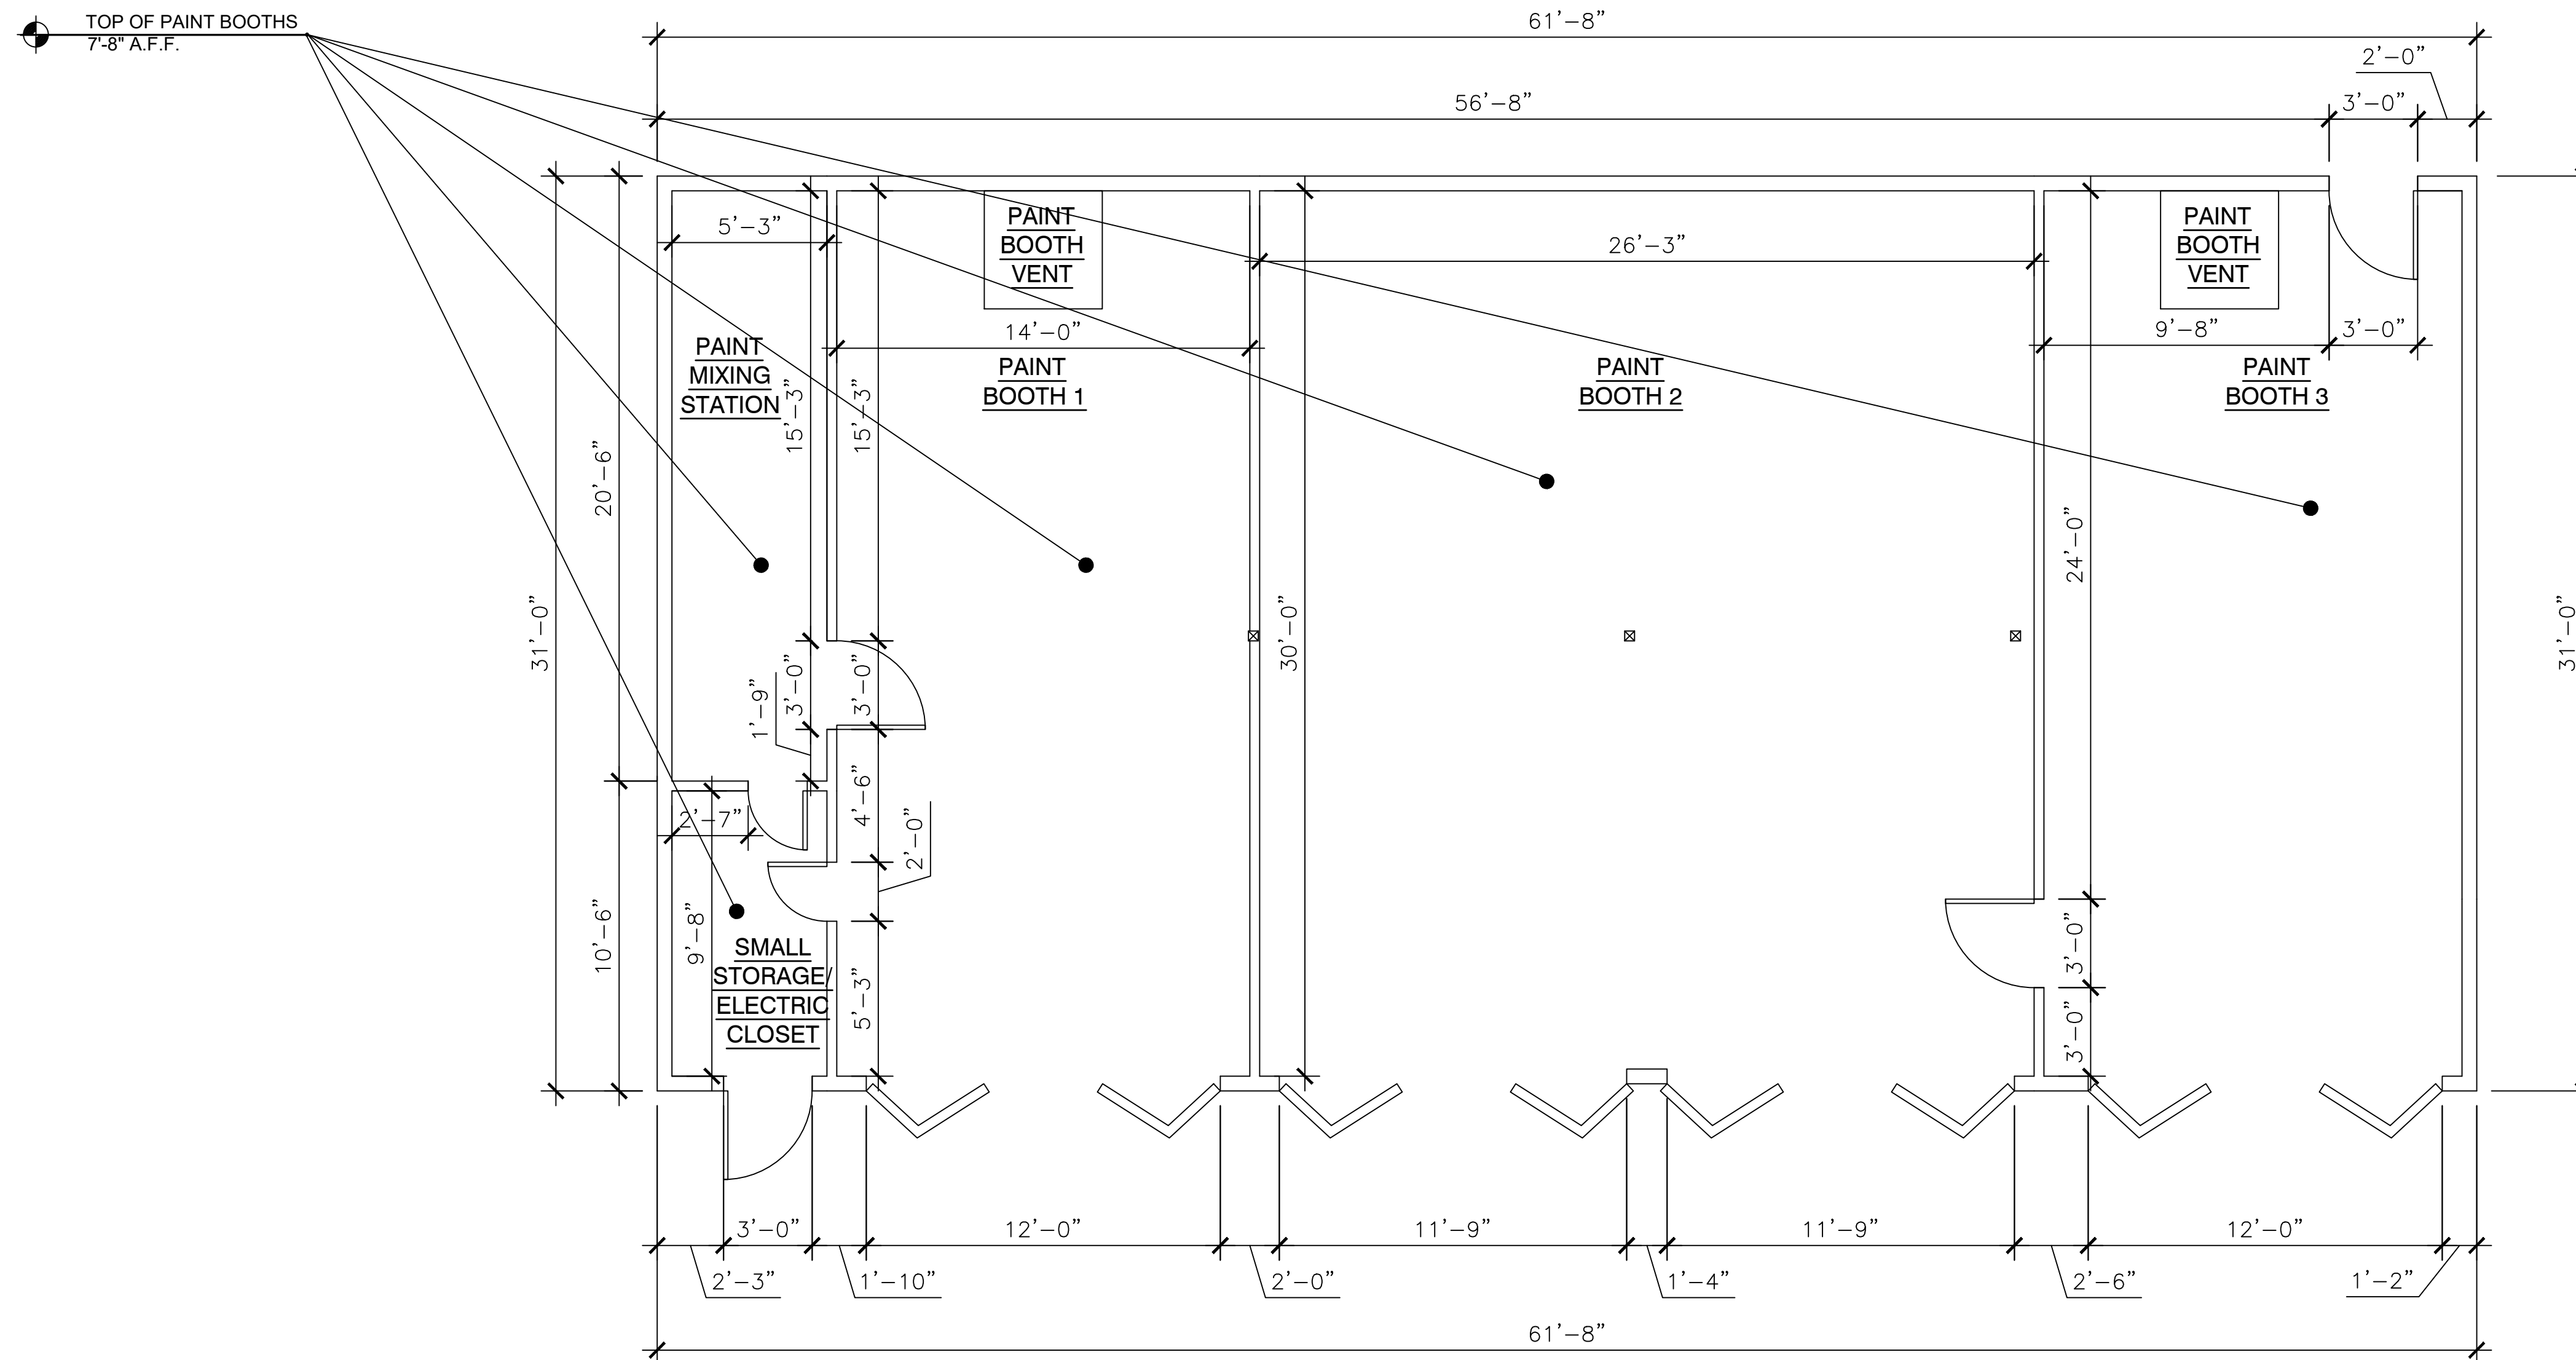

NOTES:
SUITE C HAS 1,912 SQFT

DRAWING ISSUED FOR:

REVISIONS

Δ	DATE	DESCRIPTION

DATE: 10/20/2020
DRAWN BY: C.R.
CHECKED BY: A.V.
PROJECT: A.V.
FILE NO:

SHEET TITLE:
AS-BUILT FLOOR PLAN

SHEET NO:

AB-1