

THUNDERBIRD  
MEDICAL  
PLAZA III

5310 W THUNDERBIRD ROAD, GLENDALE, AZ 85306


# Floor 02

Suite 213

AS-BUILT

2,218 SF

AVAILABLE

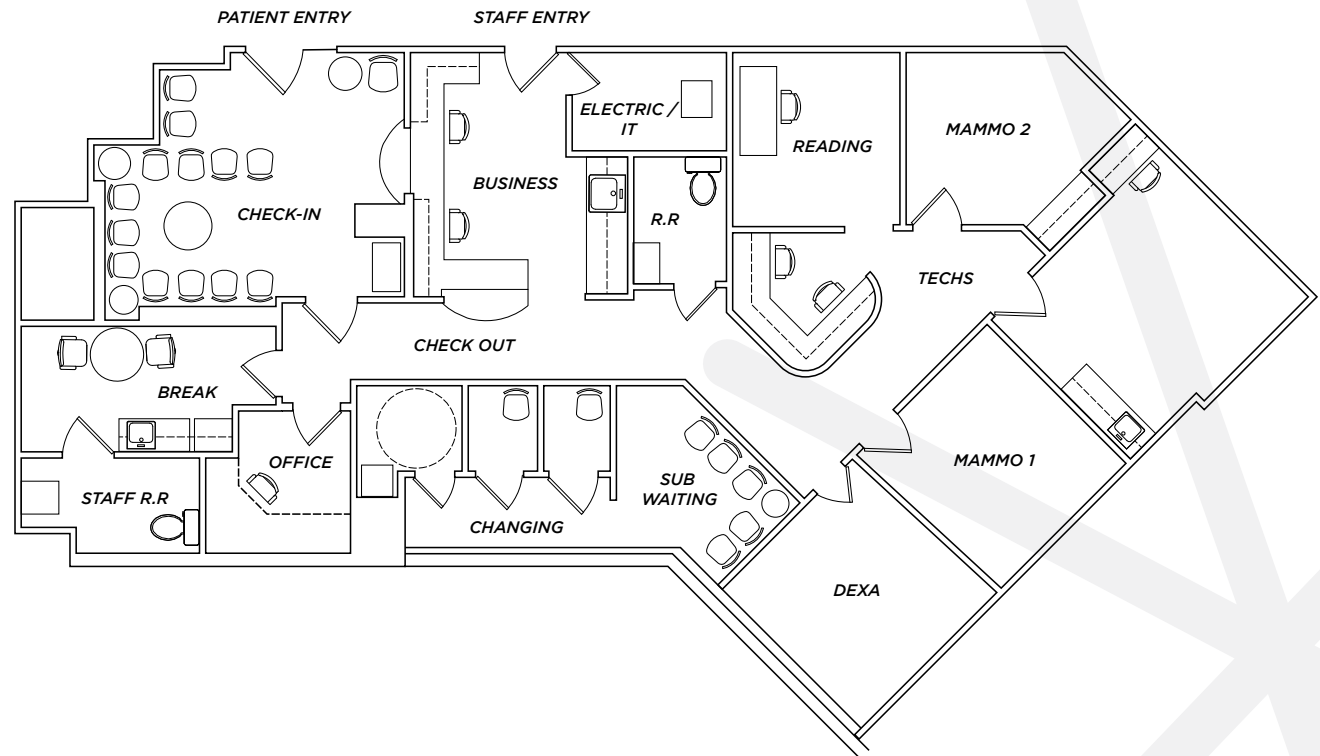

**RACHAEL THOMPSON**  
Senior Vice President  
602.513.5122  
rachael.thompson@kidder.com

**PERRY GABUZZI, CCIM**  
Executive Vice President  
602.513.5116  
perry.gabuzzi@kidder.com



View Portfolio