


325 HAMMOND DRIVE
ATLANTA, GA 30328

3RD FLOOR

SUITE 304
889 USF
1,039 RSF

SUITE 303 B
926 USF
1,082 RSF

SUITE 303
3,338 USF
3,901 RSF

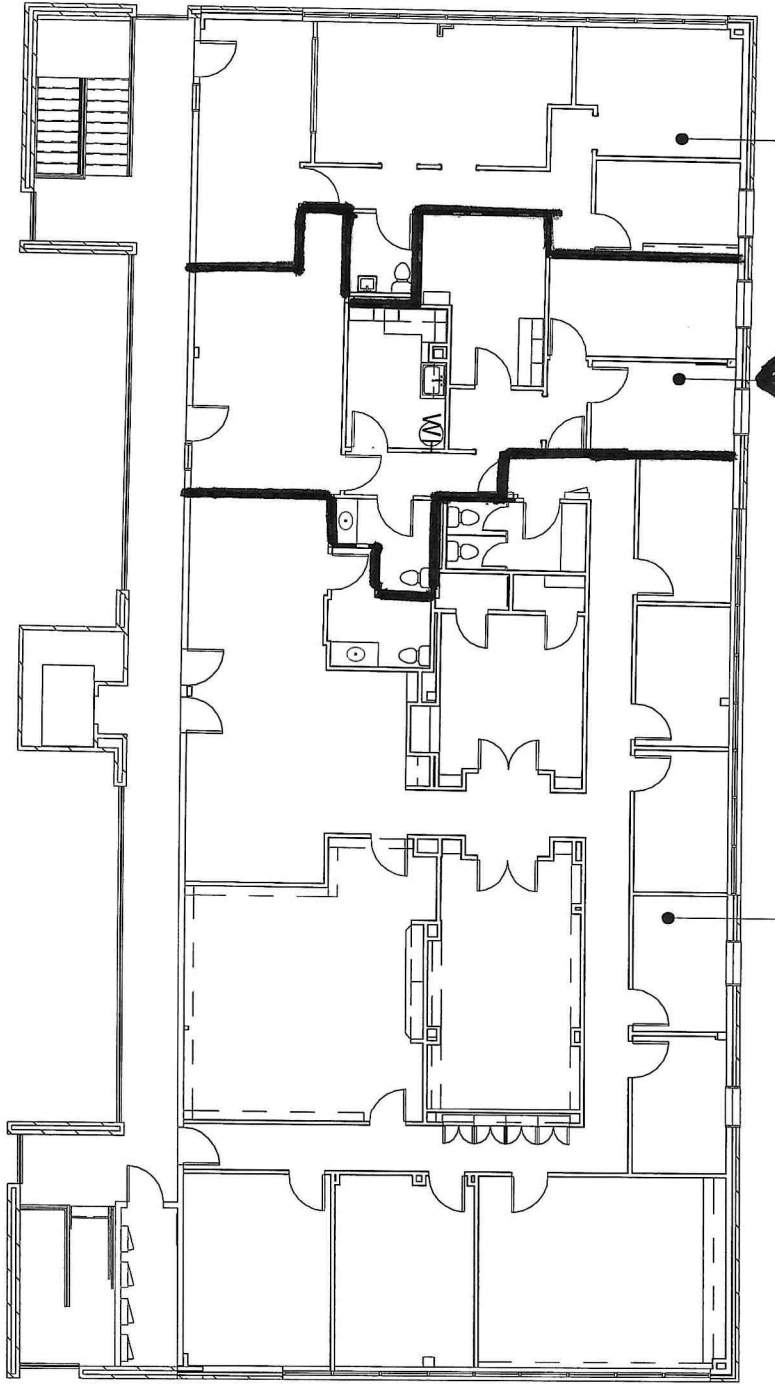

HUGHES TURNER PHILLIPS
ARCHITECTURE | INTERIOR DESIGN | SPACE PLANNING

Information contained herein has been provided to broker by owner or from other sources. We have no reason to doubt its accuracy, but we do not guarantee it. Broker disclaims all expressed or implied responsibilities for emissions, errors, environmental conditions of soil / structure, operating systems, the roof, price and compliances with applicable laws. Suitability for intended use or any other matter is the responsibility of the purchaser or tenant. Prospective purchasers or tenants agree to independently obtain and analyze all material information.

3RD FLOOR PLAN OF SUITE 303, ATLANTA, GA 30328 (4/23/2011) 17X22 28.875