


LAKE SHORE

18101 VON KARMAN AVENUE

4th floor

"AVAILABLE"
SUITE 400 | 22,944 RSF

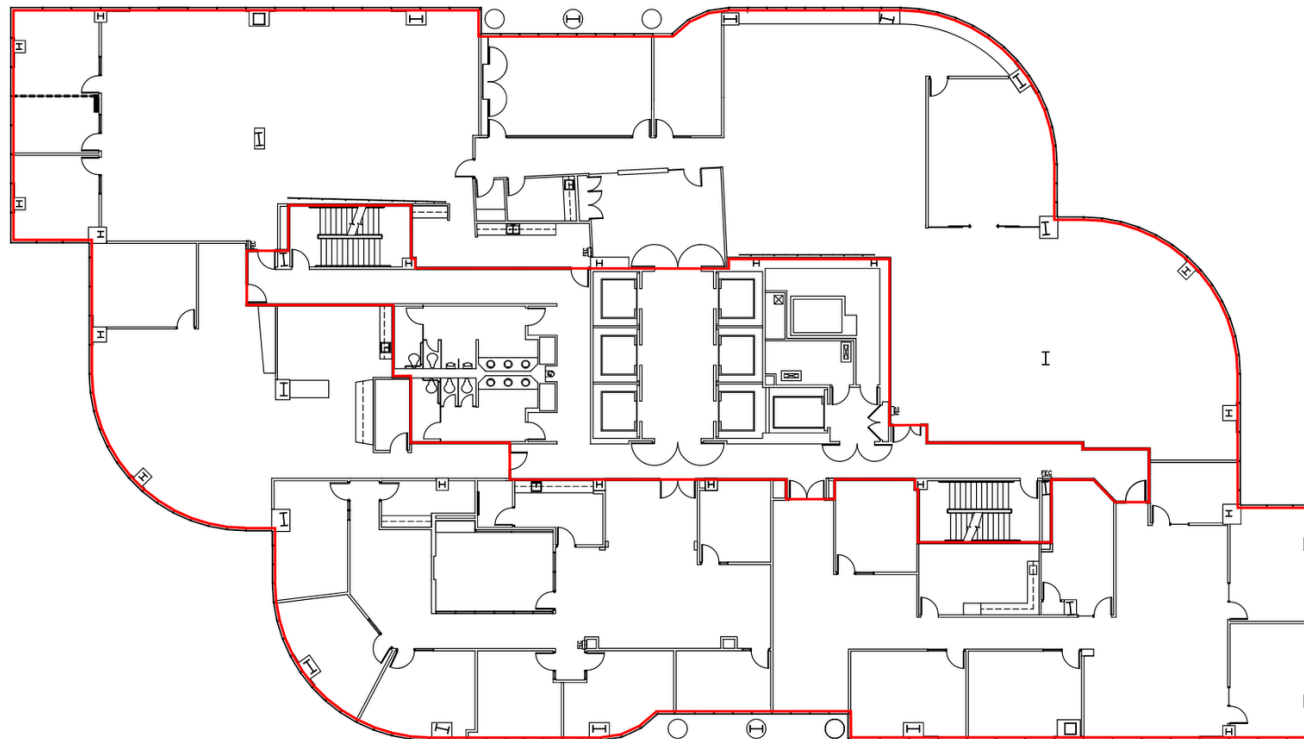

405 FREEWAY



AIRPORT



SCALE: N.T.S.



SENTRE

REVISED: 1/17/26