


1 **Reduced As-built**
Suite 1007

Scale: 3/32" = 1'-0"



North

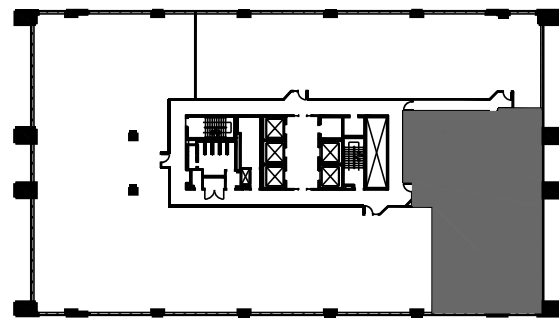

Proximity Plan

Suite 1007
The Chancery
4,313 RSF