
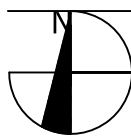


320 West Superstition Boulevard

Apache Junction . Arizona

Suite 115 - 1,100 SF

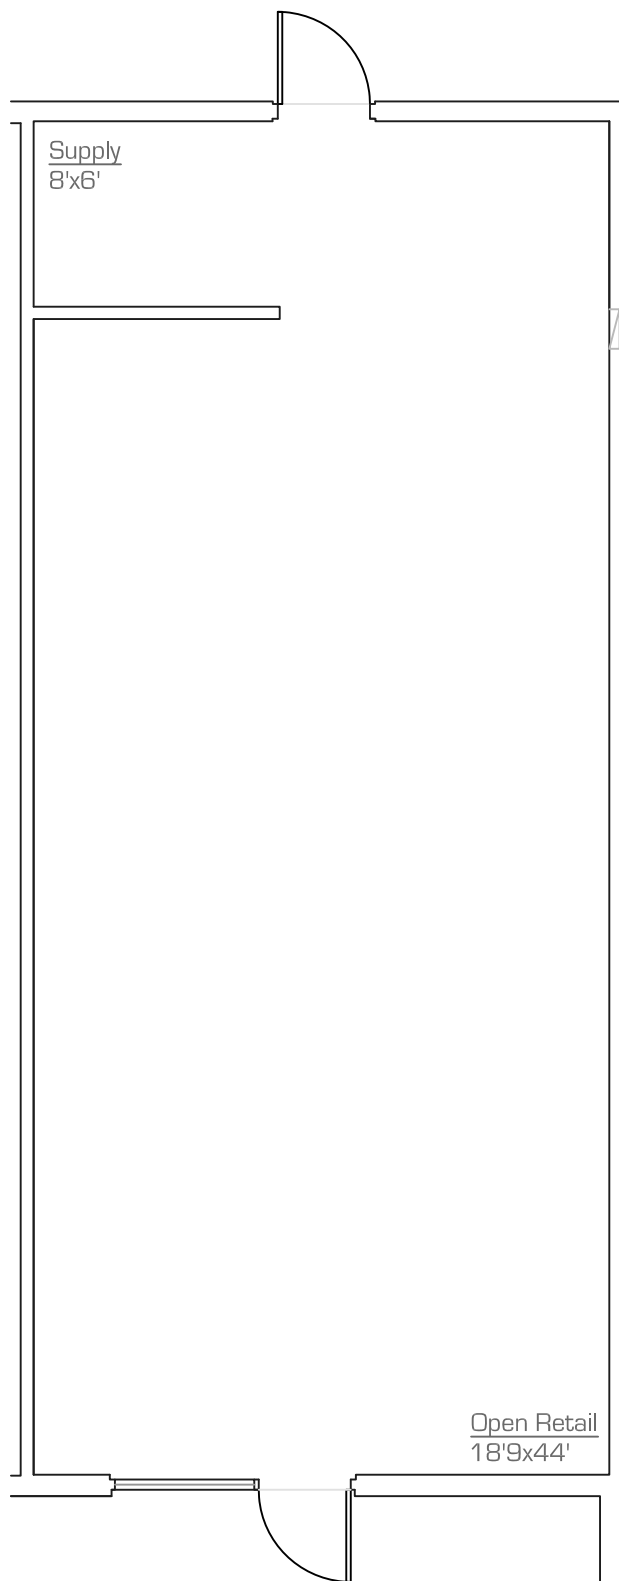

As-Built

scale: nts

15.June.2017

*All dimensions are approximate at $\pm 3"$

*All information is of general nature

precision**DIMENSIONS**

as-built & design
602. 790. 6412

